

RANKIN

K166

10-21-79

E 404

10-21-79

MISSISSIPPI BOARD OF WATER COMMISSIONERS
416 North State Street
Jackson, Mississippi 39201

CODED

WATER WELL DRILLERS LOG

1974 JACK Guinn RANKIN
date well completed firm name county well located

LANDOWNER:
W.P. Lewis

(mailing address)

WELL LOCATION:
sec. 14 T 5 N R 2 E
S W

miles (distance) of (direction) (nearest town)

WELL PURPOSE:
(home, irrigation, municipal, industrial)

WELL COMPLETION DATA:



- (1) diameter (inches) 4"
- (2) total depth (feet) 715'
- (3) static water level (feet) 200' below top of ground.
- (4) casing IAC (material) 700' (depth)
4" x 2" (size) If telescope see back.
- (5) screen 15' (length) 700' (depth to top)
2" (size) SS (material)
- (6) pump 1 1/2 (HP) 15 (yield gpm)
MPC (type power)
- (7) electric log yes (yes or no)
US GS (organization running log)
- (8) how well bottom plugged B.V.

description of formations encountered	from	to
CLAY	0	2
SAND	2	400
CLAY	40	120
SAND	120	135
CLAY	135	443
SANDY SHALE	443	660
SAND	660	748
CODED		
MISSISSIPPI BOARD OF WATER COMMISSIONERS		
DEC 10 1979		
MISS. BD. OF WATER COMM		

DRILLERS REMARKS:

If well telescopes please sketch and show depths.

GROUND LEVEL

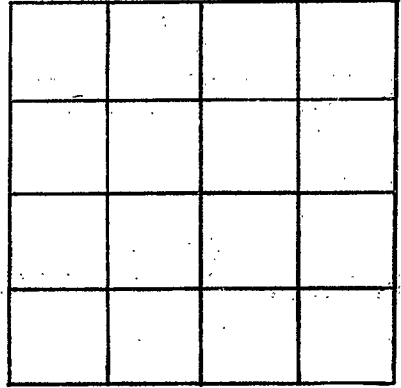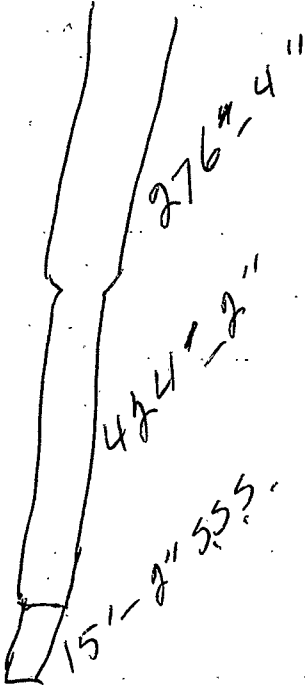

SECTION _____

Please indicate well location X.

ADDITIONAL INFORMATION

A series of horizontal lines for providing additional information.

If more than one screen, show locations of each on sketch.