

RANKIN  
K 168  
9/23/74

MISSISSIPPI  
BOARD OF WATER COMMISSIONERS  
416 North State Street  
Jackson, Mississippi 39201 CODED

WATER WELL DRILLERS LOG


9/23 1974 Forest Drilling Ser. Rankin  
date well completed firm name county well located

LANDOWNER:	description of formations encountered	from	to
Kleen Steel Mfg. Co.	Clay	0	20
Flamwood, Miss	Sand	20	25
(mailing address)	Clay	25	173
WELL LOCATION:	fine sand + clay	173	188
sec. <u>1</u> T. <u>5</u> N. R. <u>1</u> E	Clay	188	216
(distance) miles of (direction) (nearest town)	Clay & St. fine sand	216	274
WELL PURPOSE:	fine sand + clay	274	297
(home, irrigation, municipal, industrial)	Clay	297	307
WELL COMPLETION DATA:	Clay & St. rock	307	348
(1) diameter (inches) <u>4x2 1/2</u>	Clay	348	409
(2) total depth (feet) <u>751</u>	rock	409	425
(3) static water level (feet) <u>173</u> below top of ground.	Clay + rock	425	430
(4) casing <u>Galv.</u> (material), <u>751</u> (depth)	Shale	430	450
(size) If telescope see back.	Shale + St. fine sand	450	471
(5) screen <u>20'</u> (length), <u>731</u> (depth to top)	Dark Shale	471	571
<u>2 1/2"</u> (size), <u>\$47008</u> (material)	fine sand	571	627
(6) pump <u>5</u> (HP), <u>40</u> (yield gpm)	Dark Shale	627	631
<u>electric - 220V</u> (type power)	Hard Shale	631	651
(7) electric log <u>no</u> (yes or no)	fine sand + St. clay	651	695
(organization running log)	fine sand	695	711
(8) how well bottom plugged <u>2" B.W. Galv.</u>		711	751
DRILLERS REMARKS:			

DEC 2 1974  
MISSISSIPPI BOARD OF WATER COMMISSIONERS

If well telescopes please sketch and show depths.

GROUND LEVEL

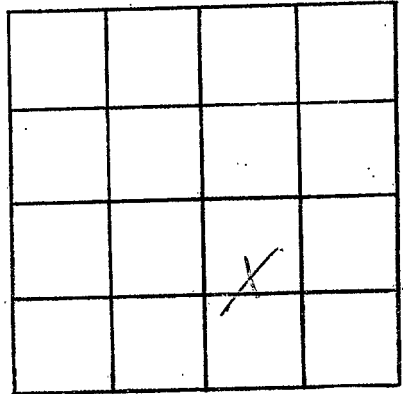

SECTION 1

Please indicate well location X.

ADDITIONAL INFORMATION

If more than one screen, show locations of each on sketch.