

RANKIN
K171
9-25-78
Elog #452

MISSISSIPPI
BOARD OF WATER COMMISSIONERS
416 North State Street
Jackson, Mississippi 39201

CODED

WATER WELL DRILLERS LOG

9/25/78 date well completed 1978 Jacksonville water well firm name Rankin county well located

LANDOWNER Crossview
Nursery Rt. 4
Jackson, ms.
(mailing address)

description of formations encountered	from	to
	Clay	0
Sand	22	25
Blue clay	25	285
Shale & Blue Clay	285	308
Shale	308	347
Shale	347	510
Lime Coat & Shale	510	554
Sand & shell	554	620
Shell	620	625
Sand & shell	625	647
Sand	647	664
Shell	664	677
Sand	677	714
Sand	714	729
Water and	729	766

WELL LOCATION:
sec. 22 (T) 5 (N) 2 (E) W
4 miles av. of Brandon
(distance) (direction) (nearest town)

WELL PURPOSE:
(home, irrigation, municipal, industrial)

- WELL COMPLETION DATA:
- (1) diameter (inches) 4 in.
 - (2) total depth (feet) 300 ft.
 - (3) static water level (feet) 190 below above top of ground.
 - (4) casing P.V.C. 40, 736
(material) (depth)
(size) If telescope see back.
 - (5) screen 20 ft., 736-766
(length) (depth to top)
4 in., P.V.C. 40
(size) (material)
 - (6) pump 5, 40 gal.
(HP) (yield gpm)
Electric
(type power)
 - (7) electric log yes
(yes or no)
m. S. S.
(organization running log)
 - (8) how well bottom plugged back
wash valve


DRILLERS REMARKS:

RECEIVED
SEP 27 1978

MISS. BD. OF WATER

If well telescopes please sketch and show depths.

GROUND LEVEL

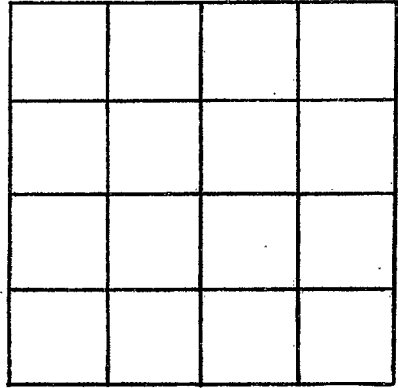

SECTION _____

Please indicate well location X.

ADDITIONAL INFORMATION

If more than one screen, show locations of each on sketch.