



RANKIN
K172
10/19/78
Elev. #478
10/19

MISSISSIPPI
BOARD OF WATER COMMISSIONERS
416 North State Street
Jackson, Mississippi 39201

CODED

WATER WELL DRILLERS LOG

1978 Jack Quinn Rankin
date well completed firm name county well located

LANDOWNER: Billups Sr. Station
description of formations encountered: yellow sand, sand & shell, sand
from: 0, 40, 240
to: 40, 240, 280
(mailing address)

WELL LOCATION: sec. 2405 N R 1E
1 miles Jackson 403' on elec. log
(distance) (direction) (nearest town)
Oct 19-1978
JRC

WELL PURPOSE: (home, irrigation, municipal, industrial)

WELL COMPLETION DATA:
(1) diameter (inches) 6 1/2 in.
(2) total depth (feet) 400 ft.
(3) static water level (feet) 130 below top of ground.
(4) casing P.V.C. 40 240 ft. (material) (depth)
4 in. (size) if telescope see back.
(5) screen 40 ft. 220 ft. (length) (depth to top)
4 in. (size) P.V.C. (material)
(6) pump 5 50 gal. (HP) (yield gpm)
Electric (type power)
(7) electric log yes (yes or no)
M.S.D. (organization running log)
(8) how well bottom plugged Back wash valve

CODED

RECEIVED


JAN 8 1978

DRILLERS REMARKS:

MISS. BD. OF WATER COMM

If well telescopes please
sketch and show depths.

GROUND LEVEL

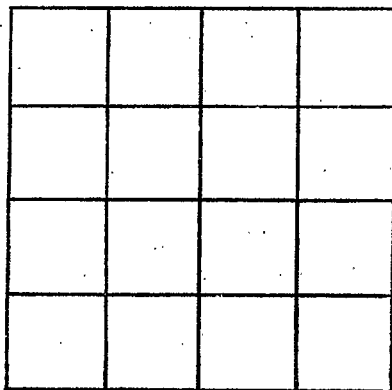

SECTION _____

Please indicate well location: X.

ADDITIONAL INFORMATION

If more than one screen,
show locations of each on sketch.