

RANKIN
K173
11-13-78
E log # 479
11-13-78

MISSISSIPPI
 BOARD OF WATER COMMISSIONERS
 416 North State Street
 Jackson, Mississippi 39201

WATER WELL DRILLERS LOG

GUINN WATER WELL SERV RINKIN

date well completed

firm name

county well located

LANDOWNER:
JAMES R. LONG
 (mailing address)

description of formations encountered	from	to
CLAY SAND	0	20
	20	30

WELL LOCATION:
 sec. 35 T. 5 N R. 1 E
 (distance) miles (direction) of (nearest town)

WELL PURPOSE:
 (home, irrigation, municipal, industrial)

WELL COMPLETION DATA:

(1) diameter (inches) 4

(2) total depth (feet) 30

(3) static water level (feet) 20 below top of ground.

(4) casing PVC 20 below top of ground.
 (material) (depth)

4 if telescope see back.
 (size)

(5) screen 10 20
 (length) (depth to top)

4 PVC
 (size) (material)

(6) pump 3/4 20
 (HP) (yield gpm)

(type power)

(7) electric log YES
 (yes or no)
M & S
 (organization running log)

(8) how well bottom plugged BWL

Spud 100' or 2 log


RECEIVED
DEC 13 1978

DRILLERS REMARKS:

MISS. BD. OF WATER COMMISSIONERS

If well telescopes please sketch and show depths.

GROUND LEVEL

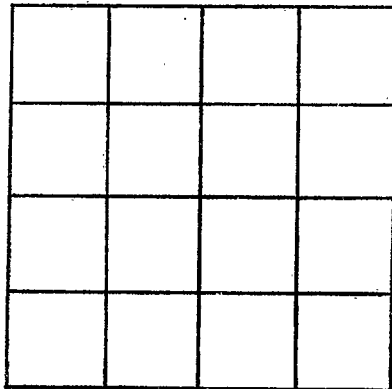

SECTION _____

Please indicate well location X.

ADDITIONAL INFORMATION

If more than one screen, show locations of each on sketch.