

MISSISSIPPI DEPARTMENT OF NATURAL RESOURCES

Bureau of Land and Water Resources

Southport Mall

P.O. Box 10631

Jackson, Mississippi 39209

WATER WELL DRILLERS LOG

CODED

K181
RANKIN
7-10-84

7/10/84 date well completed      HERNDON WELL firm name      RANKIN county well located

LANDOWNER: Herndon well  
 + Supply Pearl, ms.  
 Pearl Ms.  
 (mailing address)

description of formations encountered	from	to
Sandy Clay	0	10
Sand & Clay / S+Ks	10	19
Sand	19	30
Clay	30	32

WELL LOCATION:  
 sec. 13 T 5 N R 1 E  
 City Limits of Pearl  
 (distance) miles (direction) of (nearest town)

WELL PURPOSE: Heat-pump  
 (home, irrigation, municipal, industrial)

- WELL COMPLETION DATA:
- (1) diameter (inches) 6"
  - (2) total depth (feet) 30
  - (3) static water level (feet) 12 below/above top of ground.
  - (4) casing PVC, 30 (material) (depth)
  - (size) if telescope see back.
  - (5) screen 5', 25 (length) (depth to top)
  - 6, PVC (size) (material)
  - (6) pump 1/2, 10 (HP) (yield gpm)
  - Elect. (type power)
  - (7) electric log No (yes or no)
  - (organization running log)
  - (8) how well bottom plugged cap

DRILLERS REMARKS:  
 tested 42 gpm


DEPT. OF NATURAL RESOURCES  
 BUREAU OF LAND & WATER RESOURCES

JUL 16 1984  
 RECEIVED

①

If well telescopes please sketch and show depths.

GROUND LEVEL

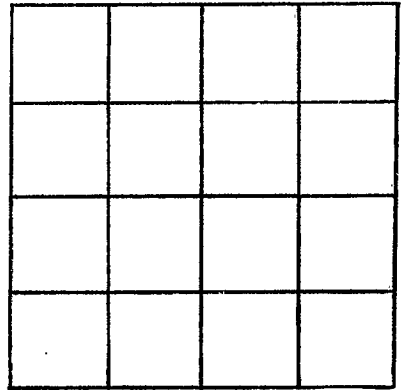

SECTION \_\_\_\_\_

Please indicate well location X.

ADDITIONAL INFORMATION

If more than one screen,  
show locations of each on sketch.