

Rankin  
K 2000  
9-14-76

MISSISSIPPI  
 BOARD OF WATER COMMISSIONERS  
 416 North State Street  
 Jackson, Mississippi 39201

WATER WELL DRILLERS LOG

9.14.76 <sup>13T</sup> McDONALD + HILL RANKIN  
 date well completed firm name county well located

LANDOWNER: REBEL MOTOR  
FREIGHT LINES, INC. PO BOX  
PEARL MISS  
 (mailing address)

WELL LOCATION:  
 sec. 10 T. S R. 2E  
 (distance) miles (direction) of PRAM (nearest town)

WELL PURPOSE:  
 (home, irrigation, municipal, industrial)

WELL COMPLETION DATA:  
 (1) diameter (inches) 4"  
 (2) total depth (feet) 330'  
 (3) static water level (feet) 90' below above top of ground.  
 (4) casing PVC 260' (material) (depth)  
4" (size) If telescope see back.  
 (5) screen 11 319' (length) (depth to top)  
2 S. STEEL (size) (material)  
 (6) pump 2 20 (HP) (yield gpm)  
F (type power)  
 (7) electric log (yes or no)  
 (organization running log)  
 (8) how well bottom plugged VALVE

description of formations encountered	from	to
<u>CLAY</u>	<u>0</u>	<u>8</u>
<u>SAND</u>	<u>8</u>	<u>30</u>
<u>BLUE CLAY</u>	<u>30</u>	<u>98</u>
<u>SANDY LIMESTONE SHELLS</u>	<u>98</u>	<u>112</u>
<u>BROWN SHALE</u>	<u>112</u>	<u>150</u>
<u>FINE SAND</u>	<u>150</u>	<u>175</u>
<u>SHALE</u>	<u>175</u>	<u>195</u>
<u>SANDY ST SHALE</u>	<u>195</u>	<u>245</u>
<u>SHALE</u>	<u>245</u>	<u>265</u>
<u>FINE SAND ST SHALE</u>	<u>265</u>	<u>290</u>
<u>FINE SAND</u>	<u>290</u>	<u>320</u>
<u>SAND</u>	<u>320</u>	<u>330</u>


**RECEIVED**  
 SEP 17 1976

MISS. BD. OF WATER COMMISSIONERS

DRILLERS REMARKS:

If well telescopes please sketch and show depths.

GROUND LEVEL

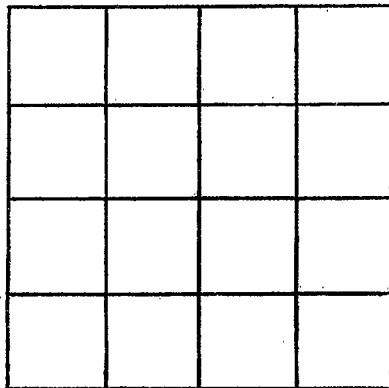

SECTION \_\_\_\_\_

Please indicate well location X.

ADDITIONAL INFORMATION

If more than one screen,  
show locations of each on sketch.