


If well telescopes please sketch and show depths.

GROUND LEVEL

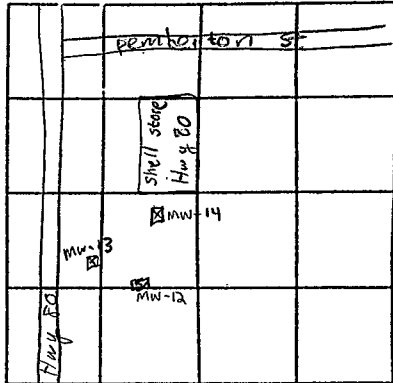

SECTION _____

Please indicate well location X.

| | | | |
|-----------------------------------|---------------|---------------|-----|
| Pump Capacity (GPM) | No. of Stages | Setting Depth | FT. |
| PUMP TEST | | | |
| Well yielded <u>0.5</u> GPM with | | | |
| a drawdown of <u>0.3</u> ft. | | | |
| after <u>0.3</u> hours of pumping | | | |

LOG DATA

TYPE OF LOG RUN (Circle One): No Log Run, Electric, Gamma Ray, Density, Sonic, Neutron, Other (Describe) _____

Name of Organization Running Log _____

GEOLOGIC DATA (Office Use Only)

| | | | |
|---------------|----------------------|----------------|--------------|
| Surface Elev. | Geologic Unit | Unit Thickness | Depth to Top |
| | <u>E₁</u> | | |
| Subs. SWL | Date | Analysis | Aquifer Test |

Driller's Remarks

ELEVATIONS

MW-12 294.40

MW-13 294.10

MW-14 294.50

Yazon CLAY located under bldg.

If more than one screen, show location of each on sketch.