

Rankin
 Simpson
 L
 5-21-80

MISSISSIPPI
 BOARD OF WATER COMMISSIONERS
 416 North State Street
 Jackson, Mississippi 39201

CODED

WATER WELL DRILLERS LOG

5-21-80 1980 date well completed
 Rankin well for Simpson firm name
 Rankin county well located

LANDOWNER:
 James Stanley
 (mailing address)

description of formations encountered	from	to
Sand & Rock	0	60
CLAY	60	100
Sand	100	132

WELL LOCATION:
 sec. 28 T 5 N R 3 E
 S W
 (distance) miles (direction) of (nearest town)

CODED

WELL PURPOSE:
 (home, irrigation, municipal, industrial)

- WELL COMPLETION DATA:
- diameter (inches) 2"
 - total depth (feet) 132
 - static water level (feet) 16 below top of ground.
 - casing PVC 112
 (material) (depth)
2 If telescope see back.
 (size)
 - screen 20 112
 (length) (depth to top)
2 PVC
 (size) (material)
 - pump 1 6
 (HP) (yield gpm)
 (type power)
 - electric log NR'S
 (yes or no)
 (organization running log)
 - how well bottom plugged 3/4

DEPT. OF NATURAL RESOURCES
 BUREAU OF LAND & WATER RESOURCES


MAY 28 1980

RECEIVED

DRILLERS REMARKS:

If well telescopes please sketch and show depths.

GROUND LEVEL

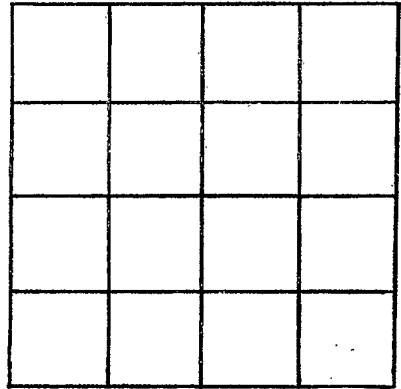

SECTION _____

Please indicate well location X.

ADDITIONAL INFORMATION

If more than one screen, show locations of each on sketch.