

**CODED**

MGS

L 26

L4

4-15-66

WATER WELL DRILLERS LOG

E LOG #130

Date: 4/15, 1966, Driller: Just Drilling County Rankin  
(Name)

(1) Owner of Land: <u>Dow Chemical Co.</u> (Name)	Description & Color of Materials Sand, Clay, Red Clay, Shell, etc.	Thick- ness Feet	Depth Feet
<u>Brandon, Miss.</u> (Address)	<u>Chalk + silt</u>		<u>20</u>
(2) Location: <u>NE 1/4, SW 1/4, Sec. 18 53</u> <u>3 mi west Brandon Hwy 80</u> <u>then 1/2 mi south on</u> (distance) (direction) (Nearest Town) <u>Whitfield Rd.</u>	<u>Blue clay</u>		<u>40</u>
(3) Topography: <input checked="" type="checkbox"/> (Hilly) <input type="checkbox"/> (Flat) <input type="checkbox"/> (Level)	<u>B. Clay + Sths Sand</u>		<u>55</u>
(4) Purpose of Well: <input type="checkbox"/> (Domestic Irrigation) <input type="checkbox"/> (Municipal, Industrial, Other)	<u>Blue clay</u>		<u>164</u>
	<u>Rock</u>		<u>165</u>
	<u>Blue clay</u>		<u>369</u>
	<u>Hard shale</u>		<u>440</u>
	<u>Soft shale + Sths rock</u>		<u>457</u>
	<u>Soft shale + Fine</u>		<u>533</u>
	<u>Hardy Myrtle</u>		<u>550</u>
	<u>Fine sand</u>		<u>575</u>
	<u>Fine sand + Sths shale</u>		<u>596</u>
	<u>Shale + Sths sand</u>		<u>618</u>
	<u>Sand + Sths shale</u>		<u>623</u>
	<u>Fine sand</u>		<u>650</u>
	<u>Shale</u>		<u>655</u>
	<u>Fine sand</u>		<u>672</u>

Information upon completion of well:

(1) Diameter 4 X 2 1/2 inches.

(2) Total Depth 671 feet.

(3) Water Level 150 feet below top of ground.

(4) Cased to 315 ft, Size 4"  
21 ft 2" below screen

(5) Screen: Size 2", Length 20 ft.


(6) Were any formations sealed against pollution?  
\_\_\_\_\_ yes,  no.

If YES depth of formation \_\_\_\_\_

Why \_\_\_\_\_

Drillers Remarks: Good Well

**CODED**

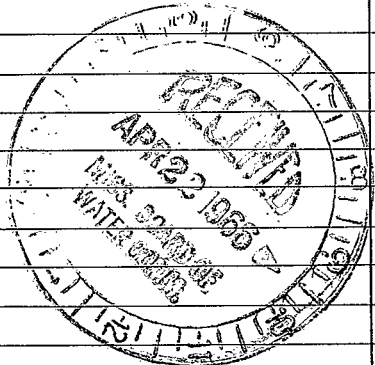

(Use Back Side)

Well No.

