

Rankin  
~~2-1-67~~  
7-66

MISSISSIPPI BOARD OF WATER COMMISSIONERS

MGS  
28

WATER WELL DRILLERS LOG

Date: July 25, 1966, Driller: Layne-Central Co. County: Rankin  
~~Rankin~~

(Name)

Taylorville Water Assoc.

(1) Owner of Land:  
3 Mi. North of (Name) Brandon, Miss.  
Brandon, Mississippi  
(Address)

(2) Location: 1/4, 1/4, Sec. 5 T5 R3,  
\_\_\_\_\_ miles \_\_\_\_\_ of \_\_\_\_\_  
(distance) (direction) (Nearest Town)

(3) Topography: \_\_\_\_\_  
(Hilly) (Flat) (Level)

(4) Purpose of Well: Municipal  
(Domestic Irrigation  
Municipal, Industrial, Other)

Description & Color of Materials Sand, Clay, Red Clay, Shell, etc.	Thickness Feet	Depth Feet
Clay	18	18
Sand, Stks. of Clay	27	45
Fine Sand, stks. shale	20	65
Clay	181	246
Shale with hard streaks	324	570
Sandy Shale	153	723
Fine Sand, few stks. of shale	68	791
Shale	4	795

COPIED

Information upon completion of well:

(1) Diameter 8 inches.

(2) Total Depth 795' feet.

(3) Water Level 210 feet below top of ground.

(4) Cased to 746', Size 8"


(5) Screen: Size 6", Length 40'

(6) Were any formations sealed against pollution?  
✓ yes, \_\_\_\_\_ no.

If YES depth of formation 746'

Why Required

Drillers Remarks:

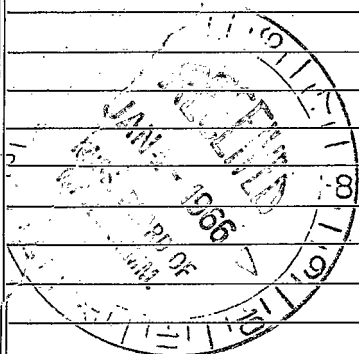

(Use Back Side)

Well No.

(1)