

L 29
8-16-60

WATER WELL DRILLERS LOG

CODED 2

Date: Aug 16, 1960, Driller: W. G. Butler County ~~Smith~~ Rankin
(Name)

(1) Owner of Land: Johnnie P. James
(Name)

Brandon, Miss. Box 116 A
(Address)

(2) Location: EW 1/2 NE 1/4, Sec. 29 T. 5 R. 3
3 miles South, of Brandon
(distance) (direction) (Nearest Town)

(3) Topography: (Hilly) (Flat) (Level)

(4) Purpose of Well: Domestic
(Domestic Irrigation, Municipal, Industrial, Other)

Description & Color of Materials Sand, Clay, Red Clay, Shell, etc.	Thick- ness Feet	Depth Feet
TOP SOIL		1
Red clay	1 to 6	
Red, Gray and Black Chalk	6 to 60	
Shale + Rock formation	60 to 90	
Shell + Sand	90 to 94	
Rock + Sand	94 to 110	
Med. Sand	110 to 120	

Information upon completion of well:

(1) Diameter 2 inches.

(2) Total Depth 120 feet.

(3) Water Level 65' feet below top of ground.

(4) Cased to 100', Size 3"

(5) Screen: Size 2", Length 6'


(6) Were any formations sealed against pollution?
_____ yes, no.

If YES depth of formation _____

Why _____

Drillers Remarks: _____

CODED

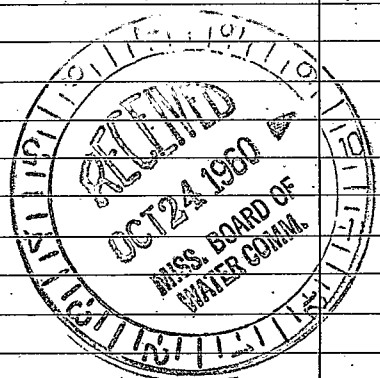

(Use Back Side)

Well No.

