

MISSISSIPPI
BOARD OF WATER COMMISSIONERS
416 North State Street
Jackson, Mississippi 39201

CODED

WATER WELL DRILLERS LOG

Rankin
L35
12-67

Dec 19 67 date well completed Wilkenson Drilling Service firm name Rankin county well located

LANDOWNER: J. D. Bryant
Brandon MISS
(mailing address)

WELL LOCATION:
sec 6 T 8 N R 3 E
S W
3 miles W of Brandon
(distance) (direction) (nearest town)


WELL PURPOSE: home
(home, irrigation, municipal, industrial)

WELL COMPLETION DATA:

- (1) diameter (inches) 2"
- (2) total depth (feet) 756
- (3) static water level (feet) 170 below top of ground.
- (4) casing Galv. 2" 744 (material) (depth)
2" if telescope see back. (size)
- (5) screen 12 744 (length) (depth to top)
2" brass 10 slot (size) (material)
- (6) pump 3 18 (HP) (yield gpm)
Elec (type power)
- (7) electric log NO (yes or no)
(organization running log)
- (8) how well bottom plugged Blw. Valve

description of formations encountered	from	to
Clay yellow	0	05
" Sand	5	10
blue clay	10	25
SAND + CLAY	25	60
SAND	69	95
Rock	95	120
blue clay	120	123
" Shale	123	420
Rock	420	495
Shale + Rock	495	497
Green Sand + Shale	497	505
Green Sand	505	510
SAND + Shale	650	670
Fine SAND	670	710
SAND	710	756

CODED

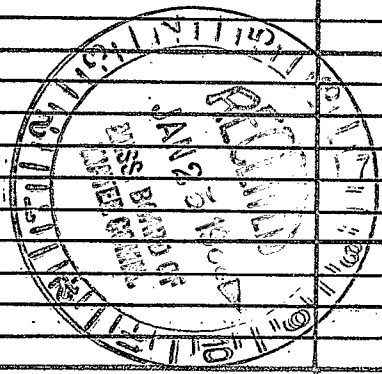

DRILLERS REMARKS:

If well telescopes please sketch and show depths.

GROUND LEVEL

X			

SECTION 6

Please indicate well location X.

ADDITIONAL INFORMATION

If more than one screen,
show locations of each on sketch.