

RANKIN  
L 30  
1-68

MISSISSIPPI  
BOARD OF WATER COMMISSIONERS  
416 North State Street  
Jackson, Mississippi 39201

**CODED**

WATER WELL DRILLERS LOG

1-18-68 19 *Trust Drilling Co* Rankin  
date well completed firm name county well located

LANDOWNER *International Paper Co.*

description of formations encountered

from to

*P.O. box 168*  
*Brandon, Mississippi*  
(mailing address)

<i>Red Clay + silt</i>	<i>7</i>	<i>20</i>
<i>Clay + silt</i>	<i>10</i>	<i>20</i>
<i>Clay</i>	<i>81</i>	<i>81</i>
<i>Soft Clay + silt</i>	<i>127</i>	<i>127</i>
<i>7' sand + clay</i>	<i>142</i>	<i>142</i>
<i>7' sand</i>	<i>146</i>	<i>146</i>
<i>Clay</i>	<i>204</i>	<i>204</i>
<i>Clay + silt</i>	<i>276</i>	<i>276</i>
<i>Clay</i>	<i>484</i>	<i>484</i>
<i>Soft shale + silt</i>	<i>534</i>	<i>534</i>
<i>Shale</i>	<i>555</i>	<i>555</i>
<i>Shale + silt</i>	<i>575</i>	<i>575</i>
<i>Shale + silt</i>	<i>596</i>	<i>596</i>
<i>Shale + silt</i>	<i>637</i>	<i>637</i>
<i>Soft shale + silt</i>	<i>657</i>	<i>657</i>
<i>Mucky sand</i>	<i>677</i>	<i>677</i>
<i>Shale + silt</i>	<i>697</i>	<i>697</i>
<i>7' sand</i>	<i>717</i>	<i>717</i>

WELL LOCATION:

sec. *11* T *5* N R *3* E  
*2* miles *N/E* of *Brandon*  
(distance) (direction) (nearest town)

WELL PURPOSE:

(home, irrigation, municipal, industrial)

WELL COMPLETION DATA:

- (1) diameter (inches) *4" x 2"*
- (2) total depth (feet) *717 ft*
- (3) static water level (feet) *212* below top of ground
- (4) casing (material) *4" galv pipe* (depth) *315 ft*

(size) if telescope see back.

- (5) screen *10 ft* (length) *707* (depth to top)  
*2"* (size) *Cook 8/5* (material)

- (6) pump (HP) (yield gpm)  
*Sub-220V* (type power)

- (7) electric log *No* (yes or no)

(organization running log)

- (8) how well bottom plugged *Backwash*

DRILLERS REMARKS:

**CODED**

**CODED**

APR 3 1968  
MISS. Bd. of WATER COMM.

If well telescopes please sketch and show depths.


GROUND LEVEL

315'  
4"  
CASING

4X2  
swedge  
NIPPLE

392'  
2"  
CASING

10'  
2" 4/8  
Screen

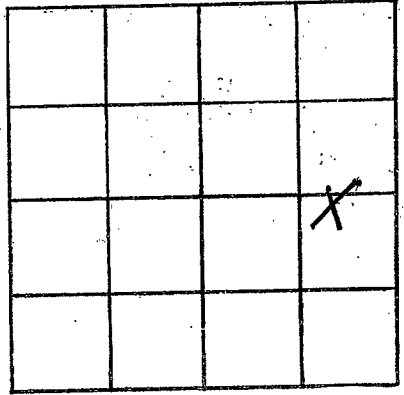

SECTION 11

Please indicate well location X.

ADDITIONAL INFORMATION

If more than one screen, show locations of each on sketch.