

RANKIN L 37

WATER WELL DRILLERS LOG

CODED

MGS

10-20-64

Date: 10-20, 1964, Driller: James McNEEL County Hinds

(Name)

(1) Owner of Land: H Warrell
 (Name)
BRANDON DRISH
 (Address)

(2) Location: 1/4, 1/4, Sec. 18 T5R3,
4 miles West, of Brandon
 (distance) (direction) (Nearest Town)

(3) Topography: (Hilly) (Flat) (Level)

(4) Purpose of Well: DOMESTIC
 (Domestic Irrigation
 Municipal, Industrial, Other)

Description & Color of Materials Sand, Clay, Red Clay, Shell, etc.	Thick- ness Feet	Depth Feet
SURFACE SOIL	10	10
CLAY	20	30
SAND	5	35
Grey shale	135	170
ROCK	1	171
Grey sh	723	494
Grey sdy sh	11	505
Grey sh	113	618
SAND	8	626
Grey sh sd sh	20	646
SAND	122	768
SAND sh limestone	20	788

Information upon completion of well:

(1) Diameter 4x2" inches.

(2) Total Depth 788 feet.

(3) Water Level 163' feet below top of ground.

(4) Cased to 726, Size _____

(5) Screen: Size 2" eol, Length 20


(6) Were any formations sealed against pollution?
 _____ yes, no.

17 lbs 4"	359
1 4" x 2" s/wedge	1
18 lbs 2"	358
	378
2-10' 00" ss	332
	20
1-17.2" o BPV	756
	2
	764

If YES depth of formation _____

Why _____

Drillers Remarks: _____

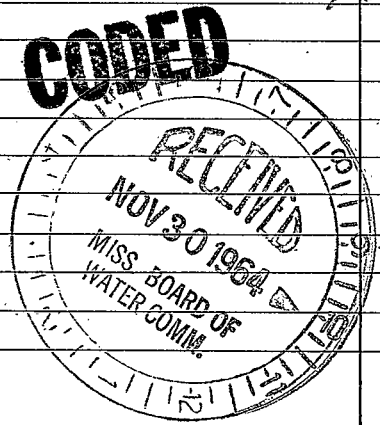

(Use Back Side)

Well No.

1950

1950