

RANKIN MISSISSIPPI BOARD OF WATER COMMISSIONERS

L 40

5-9-62

WATER WELL DRILLERS LOG


Date: 5/7 to 5/9, 1962, Driller: Johnnie Beasley

(Name)

CODED

	Description & Color of Materials Sand, Clay, Red Clay, Shell, etc.	Thick- ness Feet	Depth Feet
(1) Owner of Land: <u>Benny Comfort</u> (Name)	<u>Yellow clay.</u>	0-	25
<u>Brandon, Miss.</u> (Address)	<u>Limestone & shell.</u>	25-	85
(2) Location: <u>1/4</u> , <u>1/4</u> , Sec. <u>28</u> T <u>5R3</u> , <u>35</u>	<u>Soft clay & silt.</u>	85-	112
<u>2</u> miles <u>South</u> of <u>Brandon</u> (distance) (direction) (Nearest Town)	<u>Blue clay.</u>	112-	287
On <u> Hwy. 468</u>	<u>Blue shale.</u>	287-	514
(3) Topography: <u>x</u> (Hilly) (Flat) (Level)	<u>Hard shale.</u>	514-	560
(4) Purpose of Well: <u>Domestic.</u> (Domestic Irrigation Municipal, Industrial, Other)	<u>Lime & shale.</u>	560-	617
Information upon completion of well:	<u>Shale & stks. sand.</u>	617-	627
(1) Diameter <u>2</u> inches.	<u>Shale.</u>	627-	685
(2) Total Depth <u>825</u> feet.	<u>Silt & shale.</u>	685-	702
(3) Water Level <u>180'</u> feet below top of ground.	<u>Fine sand & stks. shale.</u>	702-	765
(4) Cased to <u>810'</u> , Size <u>2"</u>	<u>Fine sand.</u>	765-	800
(5) Screen: Size <u>2"</u> , Length <u>15'</u>	<u>Sand. (Screen setting.)</u>	800-	825
(6) Were any formations sealed against pollution? <u>no.</u>			
If YES depth of formation _____			
Why _____			
Drillers Remarks: <u>Good well.</u>			

CODED

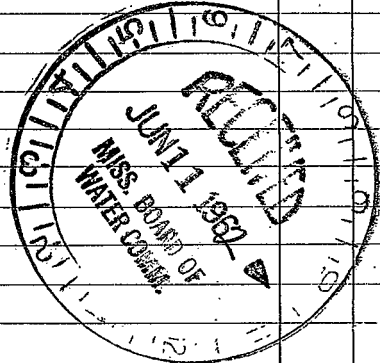

(Use Back Side)

Well No.

