

RANKIN  
L 41  
8-4-62

WATER WELL DRILLERS LOG

Date: 8-4, 1962, Driller: BUD CRESSWELL **CODED** RANKIN  
(Name)

(1) Owner of Land: ROBERT V. ELLIS  
(Name)  
BRANDON, MISS.  
(Address)

(2) Location: 1/4, 1/4, Sec. 4 T5R3,  
1 miles NORTH of DANMOR  
(distance) (direction) (Nearest Town)

(3) Topography: HILLY  
(Hilly) (Flat) (Level)

(4) Purpose of Well: DOMESTIC  
(Domestic Irrigation  
Municipal, Industrial, Other)

Description & Color of Materials Sand, Clay, Red Clay, Shell, etc.	Thick- ness Feet	Depth Feet
LIME ROCK AND SURFACE MATERIAL	40	40
GREY SDY. SHALE	20	60
BLUE MUD	20	80
BROWN SDY. SHALE with LEQUITE	40	120
BLUE CLAY WITH SAND STRS. NEAR BOTTOM	410	530
GREENISH SAND WITH SEA SHELLS	30	560
GREY SDY. SHALE	108	668
HARD GREY SHALE	20	688
GREY SDY. SHALE	60	748
GREY SAND FINE	40	788
GOOD SAND	70	858
GUNNY SHALE	10	868

Information upon completion of well:

(1) Diameter 2 inches.

(2) Total Depth 868 feet.


(3) Water Level 213 feet below top of ground.

(4) Cased to 848, Size 2" D.

(5) Screen: Size 2", Length 20'.

(6) Were any formations sealed against pollution?  
\_\_\_\_\_ yes, \_\_\_\_\_ no.

**CODED**

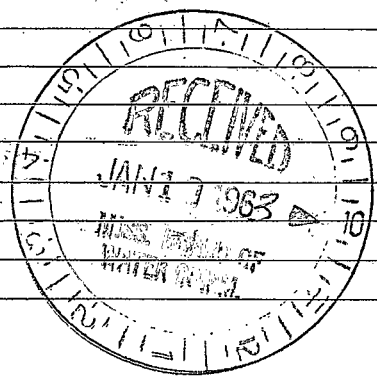

(Use, Back Side)

Well No.

