

L 44

WATER WELL DRILLERS LOG

**CODED**

3-64

Date: March, 1964, Driller: David Berry County Yazoo  
(Name)

(1) Owner of Land: E. E. Nelson  
(Name)  
Brandon, Miss.  
(Address)

(2) Location: 1/4, 1/4, Sec. 4 T5 R3,  
(distance) (direction), of           ,  
(Nearest Town)

(3) Topography: Hilly  
(Hilly) (Flat) (Level)

(4) Purpose of Well: Romantic  
(Domestic Irrigation)  
Municipal, Industrial, Other)

Description & Color of Materials Sand, Clay, Red Clay, Shell, etc.	Thick- ness Feet	Depth Feet
Clay	20	20
Clay & sand	20	40
Brown clay	160	220
Sandy shale	60	280
Brown clay	320	500
Sand fine	20	520
Sand fine	20	540
gumbo	20	560
Gumbo	20	580
Gumbo	80	660
Sand shale	20	680
Sand. shale	20	700
rock	12	712
Shale	48	760
Sand fine	20	780
Sand coarse	20	800
Sand	40	840

Information upon completion of well:

(1) Diameter 2 inches.

(2) Total Depth 840 feet.


(3) Water Level 150 feet below top of ground.

(4) Cased to 819, Size 2

(5) Screen: Size 2", Length 21

(6) Were any formations sealed against pollution?  
 \_\_\_\_\_ yes, \_\_\_\_\_ no.

**CODED**

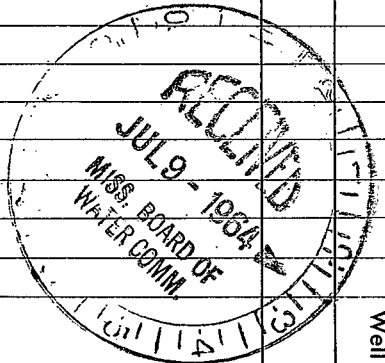

If YES depth of formation \_\_\_\_\_

Why \_\_\_\_\_

Drillers Remarks: \_\_\_\_\_

(Use Back Side)

Well No.

[The page contains extremely faint and illegible text, likely bleed-through from the reverse side of the document. No specific words or phrases can be discerned.]