

RANKIN MISSISSIPPI BOARD OF WATER COMMISSIONERS

L 46

6-11-65

WATER WELL DRILLERS LOG

**CODED**

Date: 6-11, 1965, Driller: Forest Drilling County Scott  
 (Name)

(1) Owner of Land: C. C. Reese  
 (Name)  
Brandon, Miss.  
 (Address)

(2) Location: 1/4, 1/4, Sec. 18 T5 R3  
2 miles S/W. of Brandon  
 (distance) (direction) (Nearest Town)  
1/2 mile on dirt rd

(3) Topography: \_\_\_\_\_  
 (Hilly) (Flat) (Level)

(4) Purpose of Well: Home  
 (Domestic Irrigation  
 Municipal, Industrial, Other)

Description & Color of Materials Sand, Clay, Red Clay, Shell, etc.	Thick- ness Feet	Depth Feet
<u>Brown silt</u>	<u>0</u>	<u>18</u>
<u>Chalky Clay</u>		<u>37</u>
<u>Blue Clay</u>		<u>266</u>
<u>Blue Shale</u>		<u>471</u>
<u>Soft Shale + Shell</u>		<u>530</u>
<u>Silt + silt</u>		<u>550</u>
<u>Fine sand</u>		<u>554</u>
<u>Shale + silt</u>		<u>574</u>
<u>Silt + shale</u>		<u>586</u>
<u>Shale + silt</u>		<u>595</u>
<u>Shale + silt sand</u>		<u>613</u>
<u>Fine sand</u>		<u>617</u>
<u>Fine sand + silt shale</u>		<u>627</u>
<u>Fine sand</u>		<u>666</u>

Information upon completion of well:

(1) Diameter 2 inches.

(2) Total Depth 666 feet.

(3) Water Level 174 feet below top of ground.


(4) Cased to 651, Size 2"

(5) Screen: Size 2", Length 15

(6) Were any formations sealed against pollution?  
 \_\_\_\_\_ yes,  no.

**CODED**

If YES depth of formation \_\_\_\_\_  
 Why \_\_\_\_\_  
 Drillers Remarks: \_\_\_\_\_

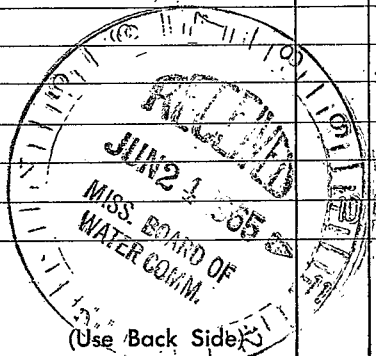

Well No. \_\_\_\_\_

