

CODED

MISSISSIPPI
 BOARD OF WATER COMMISSIONERS
 416 North State Street
 Jackson, Mississippi 39201

CODED

WATER WELL DRILLERS LOG

Rankin
L48
11-3-68

11/3/68 19 68 Forest Drilling Rankin
 date well completed firm name county well located

LANDOWNER: Mrs. Mable Cain
Brandon, Miss.

description of formations encountered	from	to
<u>Clay + streaks rock</u>	<u>0</u>	<u>40</u>
<u>Clay + streaks sand</u>	<u>40</u>	<u>61</u>
<u>Clay</u>	<u>61</u>	<u>122</u>
<u>Clay + shale</u>	<u>122</u>	<u>129</u>
<u>Rock</u>	<u>129</u>	<u>131</u>
<u>Clay + rock</u>	<u>131</u>	<u>142</u>
<u>Rock + streaks clay</u>	<u>142</u>	<u>163</u>
<u>fine sand + streaks shale</u>	<u>163</u>	<u>172</u>
<u>hard shale</u>	<u>172</u>	<u>184</u>
<u>fine sand + streaks clay</u>	<u>184</u>	<u>200</u>
<u>Clay</u>	<u>200</u>	<u>206</u>

(mailing address)

WELL LOCATION:

sec. 36 T. 5 N R. 3 E
3 miles S/E of Brandon
 (distance) (direction) (nearest town)

WELL PURPOSE: Home
 (home, irrigation, municipal, industrial)

WELL COMPLETION DATA:

- (1) diameter (inches) 2
- (2) total depth (feet) 200
- (3) static water level (feet) 136 below above top of ground.
- (4) casing Galv 190'
 (material) (depth)
- 2"
 (size) if telescope see back.
- (5) screen 10' 190'
 (length) (depth to top)
- 2" Stainless steel
 (size) (material)
- (6) pump 1 1/2 hp 4
 (HP) (yield gpm)
- Elect.
 (type power)
- (7) electric log no
 (yes or no)

CODED

(organization running log)

(8) how well bottom plugged 2" B/W
Galv


JAN - 8 1969

DRILLERS REMARKS:

MISS. BD. OF
 WATER COMMISSIONERS

If well telescopes please sketch and show depths.

GROUND LEVEL

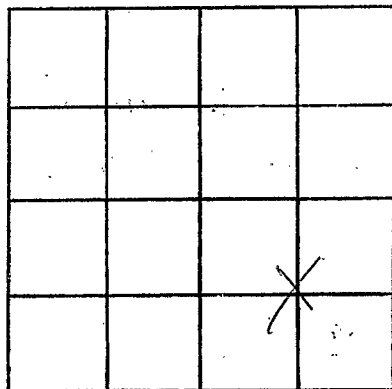

SECTION 36

Please indicate well location X.

ADDITIONAL INFORMATION

If more than one screen, show locations of each on sketch.