

RANKING

CODED

MISSISSIPPI

BOARD OF WATER COMMISSIONERS

416 North State Street

Jackson, Mississippi 39201

WATER WELL DRILLERS LOG

L58
E log #365

10-19-
date well completed

1972 Singer-Lynn Central Div
firm name

Rankin
county well located

LANDOWNER:
City of Brandon
Brandon, Miss.
(mailing address)

WELL LOCATION:
sec. 15 T. 5 N. R. 3 E
miles of (distance) (direction) of (nearest town)

WELL PURPOSE: Municipal
(home, irrigation, municipal, industrial)

- WELL COMPLETION DATA:
- (1) diameter (inches) 18"
 - (2) total depth (feet) 1307'
 - (3) static water level (feet) 302' below top of ground.
 - (4) casing Steel 1200' (material) (depth)
 - 18" if telescope see back. (size) 60" x 10"
 - (5) screen 80' 1200' (length) (depth to top)
 - 10" Stainless Steel W.W. (size) (material)
 - (6) pump 125 600 (HP) (yield gpm)
 - Electric (type power)
 - (7) electric log Yes (yes or no)
 - Miss. Geol. Survey (organization running log)
 - (8) how well bottom plugged Valve

description of formations encountered	from	to
Red Sand	0	33
Blue Clay	33	58
Lime Rock	58	59
Blue Clay	59	79
Lime Rock	79	92
Clay	92	120
Sand, Struck of Clay	120	148
Hard Shale	148	165
Lime Shale + Sandy Struck	165	190
Clay	190	475
Shale	475	602
Spider Shale	602	920
Shall + Sand Struck	920	977
Hard Shale	977	993
Hard Shale + Rock Str.	993	1083
Sandy Shale	1083	1172
Shale	1172	1203
Sand + Shale, Fld.	1203	1330
Shale	1330	1338

OCT 25 1972


DRILLERS REMARKS:

MISS. BO. OF WATER COMMISSIONERS

(X)

If well telescopes please sketch and show depths.

GROUND LEVEL

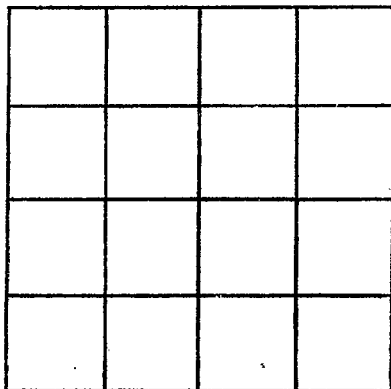

SECTION _____

Please indicate well location X.

ADDITIONAL INFORMATION

Lined area for providing additional information, consisting of approximately 20 horizontal lines.

If more than one screen, show locations of each on sketch.