

**RANKIN**  
**L60**  
**4-8-75**  
**EL# 411**

MISSISSIPPI  
 BOARD OF WATER COMMISSIONERS  
 416 North State Street  
 Jackson, Mississippi 39201

**WATER WELL DRILLERS LOG**

4-8-75 1975 **JACK Quinn** **RANKIN**  
 date well completed firm name county well located

**LANDOWNER:**  
 HUTCHINSON  
 (mailing address)  
**WELL LOCATION:**  
 sec 36 T 5 N R 3 E  
 (distance) miles (direction) of (nearest town)

| description of formations encountered | from | to  |
|---------------------------------------|------|-----|
| SAND                                  | 0    | 10  |
| ROCK                                  | 10   | 12  |
| CLAY                                  | 12   | 130 |
| ROCK                                  | 130  | 212 |
| SAND                                  | 212  | 220 |
| CLAY                                  | 220  | 228 |
| SAND                                  | 228  | 250 |

**WELL PURPOSE:**  
 (home, irrigation, municipal, industrial)

**WELL COMPLETION DATA:**

(1) diameter (inches) 4"  
 (2) total depth (feet) 242  
 (3) static water level (feet) 125 above top of ground.  
 (4) casing JAL 232 (material) (depth)  
 4" (size) if telescope see back.  
 (5) screen 10' 232 (length) (depth to top)  
 2" SS (size) (material)  
 (6) pump 1/2 (HP) 7 (yield gpm)  
 M.P.L. (type power)  
 (7) electric log yes (yes or no)  
 MBS (organization running log)  
 (8) how well bottom plugged Beaver


CODED

MISSISSIPPI BOARD OF WATER COMMISSIONERS  
 MAY - 9 1975

**DRILLERS REMARKS:**

If well telescopes please  
sketch and show depths.

GROUND LEVEL

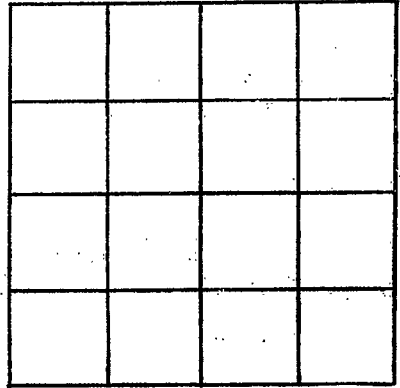

SECTION \_\_\_\_\_

Please indicate well location X.

ADDITIONAL INFORMATION

If more than one screen,  
show locations of each on sketch.