

RANKIN
L66
10-8-79
E-log # 496

MISSISSIPPI
BOARD OF WATER COMMISSIONERS
416 North State Street
Jackson, Mississippi 39201

CODED

WATER WELL DRILLERS LOG

10/8/79 date well completed
19 79 Jacke, Guinn Rankin firm name
county well located

LANDOWNER: Ruth Wadell

description of formations encountered

from to

Top soil	0	40
Sandy material	40	80
Clay	80	480
Sand & shell	480	670
Sand	670	760
Sandy shell	760	800

(mailing address)

WELL LOCATION:

sec. 18 T 5 N R 2 E
S W
2 miles W of Brandon
(distance) (direction) (nearest town)

WELL PURPOSE: Home
(home, irrigation, municipal, industrial)

WELL COMPLETION DATA:

- diameter (inches) 6 1/4 in
- total depth (feet) 860
- static water level (feet) 173 below top of ground.
- casing Steel 670 ft.
(material) (depth)
4 in. (size) if telescope see back.
- screen 20 ft. 676 ft.
(length) (depth to top)
2 in. Johnson S.S.
(size) (material)
- pump 2 HP 20 gal.
(HP) (yield gpm)
Electric
(type power)
- electric log yes
(yes or no)
M.S.S.
(organization running log)
- how well bottom plugged Back
wash valve

CODED

DEPT. OF NATURAL RESOURCES
BUREAU OF LAND & WATER RESOURCES


DEC 17 1979

DRILLERS REMARKS:

RECEIVED

If well telescopes please
sketch and show depths.

GROUND LEVEL

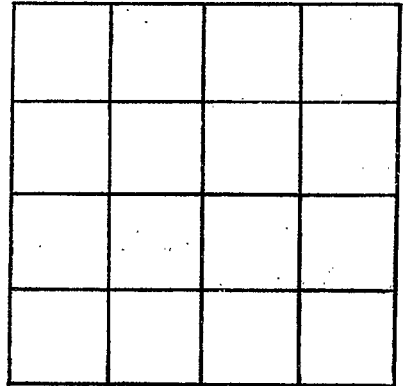

SECTION _____

Please indicate well location X.

ADDITIONAL INFORMATION

If more than one screen,
show locations of each on sketch.