

RANKIN

L 70

11-30-81

MISSISSIPPI
 BOARD OF WATER COMMISSIONERS
 416 North State Street
 Jackson, Mississippi 39201

CODED

WATER WELL DRILLERS LOG

11-30 19 81 Layne Central Co. Rankin
 date well completed firm name county well located

LANDOWNER: Norfolk Utility
Co., Inc.

P.O. Box 31758

Jackson, Ms. 39206
 (mailing address)

WELL LOCATION:

sec SE 1/4 T 5 (N) R. 3 (E) W
5 miles of Brandon
 (distance) (direction) (nearest town)

WELL PURPOSE: multi-purpose
 (home, irrigation, municipal, industrial)

WELL COMPLETION DATA:

- (1) diameter (inches) 16"
- (2) total depth (feet) 1286
- (3) static water level (feet) 238 below top of ground.
- (4) casing Steel 1195
 (material) (depth)
16" If telescope see back.
 (size)
- (5) screen 80' 72'
 (length) (depth to top)
8" Welded Wire
 (size) (material)
- (6) pump 150 750
 (HP) (yield gpm)
electric
 (type power)
- (7) electric log Yes
 (yes or no)
Layne Central Co.
 (organization running log)
- (8) how well bottom plugged Back
Pressure valve

description of formations encountered	from	to
yellow clay	1	20
hard	20	28
clay	28	570
sandy clay	570	640
shale	640	664
rock	664	665
shale	665	726
sandy shale	726	820
clay	820	865
hard shale	865	932
rock	932	933
hard shale	933	940
rock	940	943
hard shale	943	967
sandy shale	967	1077
hard shale	1077	1089
shale	1089	1153
sandy shale	1153	1189
shale	1189	1197
sand	1197	1275
hard shale	1275	1408
shale	1408	1511

DEPT. OF NATURAL RESOURCES
 BUREAU OF LAND & WATER RESOURCES


FEB - 8 1982

RECEIVED

DRILLERS REMARKS:

X

If well telescopes please sketch and show depths.

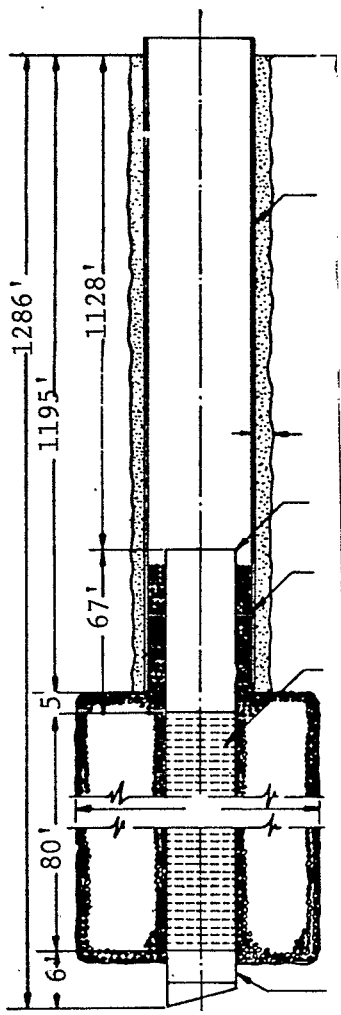

If more than one screen, show locations of each on sketch.

SECTION _____

Please indicate well location X.

ADDITIONAL INFORMATION

Horizontal lines for additional information.