

MISSISSIPPI DEPARTMENT OF NATURAL RESOURCES

Bureau of Land and Water Resources

Southport Mall

P.O. Box 10631

Jackson, Mississippi 39209

WATER WELL DRILLERS LOG

RANKIN
L 2001

JAN. 5 1987 ST. F.M. "Bud" CRESSWELL RANKIN
date well completed firm name county well located

LANDOWNER:	description of formations encountered	from	to
Mississippi Power & Light Co. (mailing address)			
WELL LOCATION: sec. 11 T. 85 N R. 3 E 1 miles North of Brandon (distance) (direction) (nearest town)			
WELL PURPOSE: Industrial (home, irrigation, municipal, industrial)			
WELL COMPLETION DATA:			
(1) diameter (inches) 4			
(2) total depth (feet) 740			
(3) static water level (feet) 220 below top of ground.			
(4) casing Steel 710 (material) (depth) 4 (size) if telescope see back.			
(5) screen 30 710 (length) (depth to top) 2 STAINLESS (size) (material)			
(6) pump 2 15 (HP) (yield gpm) - (type power)			
(7) electric log No (yes or no) - (organization running log)			
(8) how well bottom plugged BACK WASH -			


RECEIVED
JAN 23 1987

Department of Natural Resources
Bureau of Land & Water Resources

DRILLERS REMARKS:

If well telescopes please sketch and show depths.

GROUND LEVEL

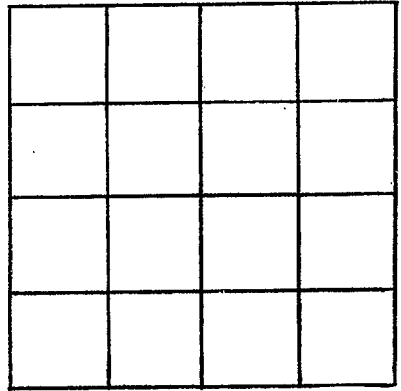

SECTION _____

Please indicate well location X.

ADDITIONAL INFORMATION

If more than one screen,
show locations of each on sketch.