

CODED

Rankin
M 22
2-67

MISSISSIPPI
BOARD OF WATER COMMISSIONERS
416 North State Street
Jackson, Mississippi 39201

WATER WELL DRILLERS LOG

Feb-4 1967 W. G. Butler Rankin
date well completed firm name county well located
Water Well Serv.

LANDOWNER: Frank Hardy
Brandon Rt 2
Miss.
(mailing address)


description of formations encountered	from	to
Red Clay	0	7
Rock + chalk	7	10
Blue chalk	10	25
Sand + chalk	25	40
Sand	40	45
Chalk	45	68
Rock	68	90
Rock + shell	90	120
Sand	120	132
Sand + chalk	132	140

WELL LOCATION:
sec 35 T 50 N R 4 E
6 miles east of Brandon
(distance) (direction) (nearest town)

WELL PURPOSE: Home
(home, irrigation, municipal, industrial)

- WELL COMPLETION DATA:
- (1) diameter (inches) 2"
 - (2) total depth (feet) 140
 - (3) static water level (feet) 75 ^{below}/_{above} top of ground.
 - (4) casing Galv, 126'
(material) (depth)
2" (size) if telescope see back.
 - (5) screen 5', 126'
(length) (depth to top)
2", S. Steel
(size) (material)
 - (6) pump 3/4 HP, 46 gal
(HP) (yefd/gpm)
Electric
(type power)
 - (7) electric log No
(yes or no)
(organization running log)
 - (8) how well bottom plugged 2" Back
wash valve


CODED

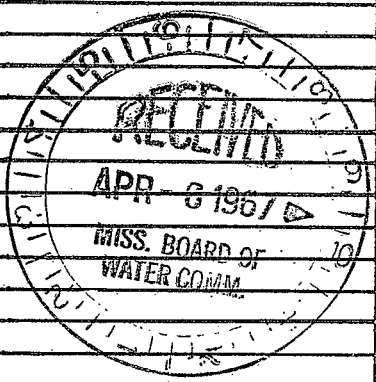

DRILLERS REMARKS:

If well telescopes please sketch and show depths.

GROUND LEVEL

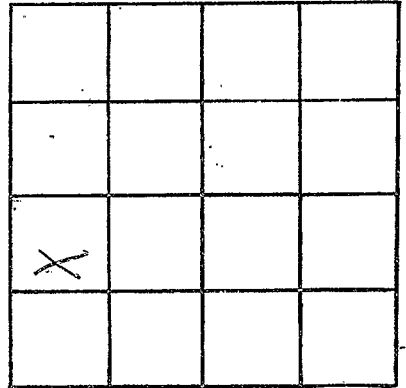

SECTION 35

Please indicate well location X.

ADDITIONAL INFORMATION

If more than one screen, show locations of each on sketch.