

CODED

MISSISSIPPI
BOARD OF WATER COMMISSIONERS
416 North State Street
Jackson, Mississippi 39201

WATER WELL DRILLERS LOG

Rankin
M 23
2-67

Feb-2 1967 W. H. Butler Rankin
date well completed firm name county well located
Water Well Service

LANDOWNER: H. J. Hardy

Brandon Rt - 2

Miss.
(mailing address)

WELL LOCATION:

sec 35 T 5(N) R 4(E)
12 miles E of Brandon
(distance) (direction) (nearest town)

WELL PURPOSE: Home
(home, irrigation, municipal, industrial)

WELL COMPLETION DATA:

- (1) diameter (inches) 2 1/4
- (2) total depth (feet) 320'
- (3) static water level (feet) 92' below above top of ground.
- (4) casing Galv, 168'
(material) (depth)
- 2" if telescope see back.
(size)
- (5) screen 10', 168'
(length) (depth to top)
- 2", S. Steel
(size) (material)
- (6) pump 3/4, 3
(HP) (yield gpm)
- Electric
(type power)
- (7) electric log No
(yes or no)


(organization running log)

- (8) how well bottom plugged 2"
Back wash valve

DRILLERS REMARKS:


description of formations encountered	from	to
Chalk + sand	0	8
Rock	8	10
Sand + chalk	10	18
Rock + chalk	18	30
Chalk	30	80
Chalk + shell	80	100
Rock + chalk	100	110
Rock	110	120
Rock + shell	120	150
Sand	150	180
Lignite + chalk	180	200
Chalk	200	214
Sand + chalk	214	267
Sand	267	267
Sand + chalk	267	277
Chalk	277	297
Shell + chalk	297	320

CODED

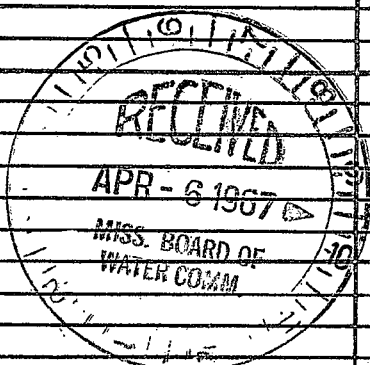

If well telescopes please sketch and show depths.

GROUND LEVEL

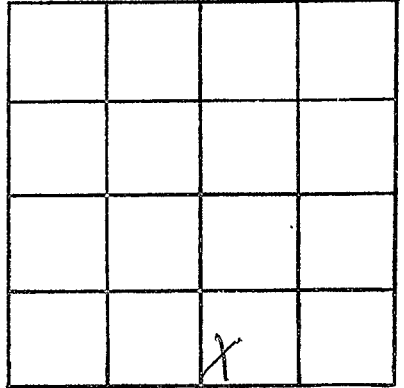

SECTION 35

Please indicate well location X.

ADDITIONAL INFORMATION

If more than one screen,
show locations of each on sketch.