

CODED

MISSISSIPPI
BOARD OF WATER COMMISSIONERS
416 North State Street
Jackson, Mississippi 39201

Rankin
M 24
7-67

WATER WELL DRILLERS LOG

July 18 1960 date well completed
W. G. Butler firm name
Water Well Service Rankin county well located

LANDOWNER: Ever Mac Brown
Brandon, Miss
(mailing address)

description of formations encountered	from	to
Red Clay	1	5
Red Sand	5	10
Sand + Chalk	10	20
Fine Sand	20	30
Sand	30	67
Rock	67	70
Chalk	70	80
Sand	80	85
Rock	85	90
Rock + Sand	90	100
Rock	100	120
Rock - Chalk - Lignite	120	130
Rock - Chalk	130	140
Chalk	140	164
Chalk + Shell	164	174
Rock	174	207
Rock + Shell	207	217
Rock + Sand	217	238
Sand	238	248

WELL LOCATION:
Sec 33 T 5 N R 4 E
S W
5 miles E of Brandon
(distance) (direction) (nearest town)

WELL PURPOSE: Home
(home, irrigation, municipal, industrial)

WELL COMPLETION DATA:
(1) diameter (inches) 2"
(2) total depth (feet) 248'
(3) static water level (feet) 180 ^{below} above top of ground.
(4) casing galv. 210'
(material) (depth)
2" if telescope see back.
(size)
(5) screen 10' 210'
(length) (depth to top)
2" S. Steel
(size) (material)
(6) pump 3/4 3
(HP) (yield gpm)
Elec
(type power)
(7) electric log NO
(yes or no)


(organization running log)
(8) how well bottom plugged 2" galv.

DRILLERS REMARKS:

CODED

If well telescopes please sketch and show depths.

GROUND LEVEL

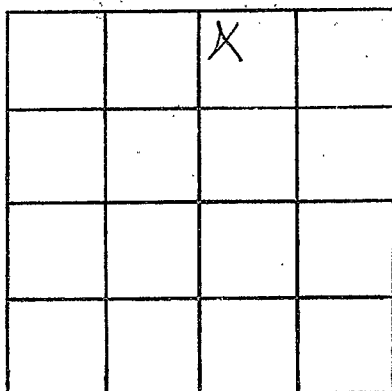

SECTION 33

Please indicate well location X.

ADDITIONAL INFORMATION

If more than one screen,
show locations of each on sketch.