

CODED

MISSISSIPPI
BOARD OF WATER COMMISSIONERS
416 North State Street
Jackson, Mississippi 39201

WATER WELL DRILLERS LOG

W. G. Butler

Rankin
M 25
9-67

Sept. 21 1967 Water Well Service Rankin
date well completed firm name county well located

LANDOWNER: Mary Ann Ticken

Brandon, Miss
Rt

description of formations encountered from to

(mailing address)

WELL LOCATION:
sec 35 T 5 N R 4 E
S W
1 miles W of Shiloh
(distance) (direction) (nearest town)

Red Clay + Chalk	1	10
Chalk	10	40
Chalk shell. Sand	40	50
Chalk + Shell	50	70
Rock + Chalk	70	80
Rock + Shell	80	110
Shell + Sand	110	130
Chalk shell + Sand	130	140
Lignite + Chalk	140	160
Lignite + Fine Sand	160	170
Lignite	170	180
Lignite, Fine Sand + Chk	180	190
Sand + Chalk	190	210
Lignite + Sand	210	220
Sand	220	231
good Sand	231	240

WELL PURPOSE: Home
(home, irrigation, municipal, industrial)

WELL COMPLETION DATA:


- (1) diameter (inches) 2"
- (2) total depth (feet) 240'
- (3) static water level (feet) 180' ^{below}/_{above} top of ground.
- (4) casing 92/111, 231'
(material) (depth)
2" (size) If telescope see back.
- (5) screen 10', 231'
(length) (depth to top)
2" stainless steel
(size) (material)
- (6) pump 3/4, 3
(HP) (yield gpm)
Electric
(type power)
- (7) electric log NO
(yes or no)
- (organization running log)
- (8) how well bottom plugged 2" RWK

CODED

DRILLERS REMARKS:

If well telescopes please sketch and show depths.

GROUND LEVEL

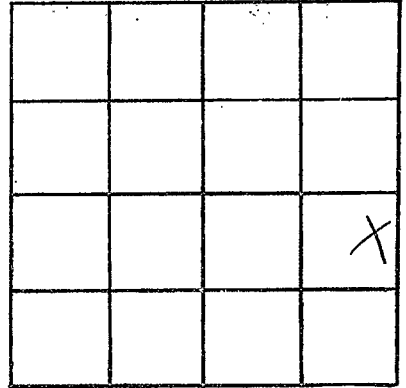

SECTION 35

Please indicate well location X.

ADDITIONAL INFORMATION

If more than one screen, show locations of each on sketch.