

CODED

MISSISSIPPI
BOARD OF WATER COMMISSIONERS
416 North State Street
Jackson, Mississippi 39201

Rankin
M 26
9-67

WATER WELL DRILLERS LOG

W.G. Butler

Sept. 18 1967 date well completed
Water Well Service Rankin firm name
Rankin county well located

LANDOWNER Ernest Lock

description of formations encountered from to

Brandon, Miss.
(mailing address)

Rock & Chalk	1-	50
Brown Chalk & Rock	50	80
Rock & Chalk	80	100
Chalk & Shell	100	110
Shell & Rock	110	120
Rock & Chalk	120	140
Rock	140	145
Sand	145	160
Sandstone Nite	160	170
Chalk	170	190
Chalk & Nite	190	200
Sand & Chalk	200	231
Chalk, Fine Sand, & L.	231	241
Chalk & Sand	241	251
Sand	251	262
Chalk	262	272

WELL LOCATION:

sec 33 T 5 N R 4 E
S W
5 miles E of Brandon
(distance) (direction) (nearest town)

WELL PURPOSE: Home
(home, irrigation, municipal, industrial)

WELL COMPLETION DATA:


- (1) diameter (inches) 2"
- (2) total depth (feet) 273'
- (3) static water level (feet) 180' below top of ground.
- (4) casing 2 1/2" (material) 252' (depth)
- 2" If telescope see back.
(size)
- (5) screen 10' (length) 252' (depth to top)
- 2" Stainless Steel
(size) (material)
- (6) pump 3/4 (HP) 3 (yield gpm)
- Electric
(type power)
- (7) electric log No
(yes or no)
- (organization running log)
- (8) how well bottom plugged 2" Sand

CODED

DRILLERS REMARKS:

If well telescopes please sketch and show depths.

GROUND LEVEL

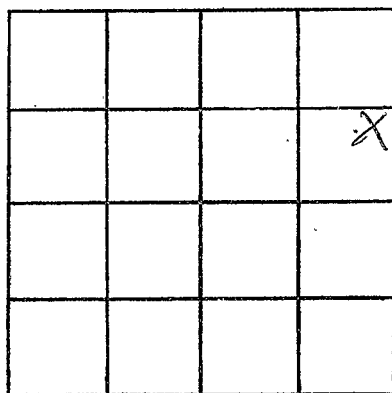

SECTION 33

Please indicate well location X.

ADDITIONAL INFORMATION

If more than one screen, show locations of each on sketch.