

RANKIN
M 27
8-28-64

WATER WELL DRILLERS LOG

CODED

Date: 8 28, 19 64, Driller: Frank Dilling County: Rankin
(Name)

(1) Owner of Land: W.A. Martin
(Name)
Rt 2 Brandon, Miss.
(Address)
(2) Location: 1/4, 1/4, Sec. 8 T5 R4
miles n. of Rankin
(distance) (direction) (Nearest Town)
at Stearns' bro
(3) Topography: _____
(Hilly) (Flat) (Level)
(4) Purpose of Well: Home
(Domestic Irrigation
Municipal, Industrial, Other)

Description & Color of Materials Sand, Clay, Red Clay, Shell, etc.	Thick- ness Feet	Depth Feet
Red Clay	0	5
Brown Clay		27
Blue Clay		32
Clay		82
Clay + 1/4 Sh. Mky Sand		102
Clay		142
Shale		140
Hard Shale		190
Shale + 1/4 Sh. Rock		500
Clay + Shell		520
Shale		530
Soft Shale		574
Shale + 1/4 Sh. Sand		586
Soft Shale + mky. Sand		606
Soft Shale + 1/4 Sh. Sand		616
Soft Shale		626
Soft Shale + 1/4 Sh. Sand		646
Shale		676
Shale + 1/4 Sh. Rock		686
Shale		727
Fine Sand		737
Fine Sand + 1/4 Sh. Clay		752
Shale + 1/4 Sh. Sand		774
Fine Sand + 1/4 Sh. Clay		784
Fine Sand		804
Fine Sand		820


Information upon completion of well:

(1) Diameter 2 inches.
(2) Total Depth 820 feet.
(3) Water Level 200 feet below top of ground.
(4) Cased to 805, Size 2"
(5) Screen: Size 2", Length 15ft
(6) Were any formations sealed against pollution?
_____ yes, X no.

If YES depth of formation _____
Why _____

Drillers Remarks: _____

CODED

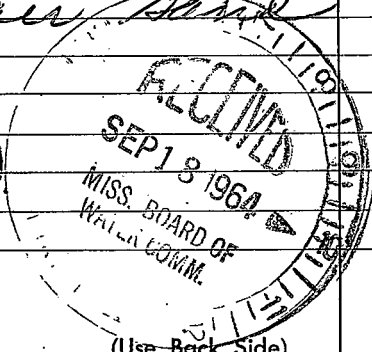

Well No.

