

SE Grant

RANKIN
M 30
6-30-69
Miss Geo

MISSISSIPPI
BOARD OF WATER COMMISSIONERS
416 North State Street
Jackson, Mississippi 39201

~~ROBERT E. RATLIFF~~
2177

WATER WELL DRILLERS LOG

June 30 19 69 Robert E. Ratliff Co. Rankin
date well completed firm name county well located

LANDOWNER: Middle Miss.
Girl Scout Council
Camp WATH
(mailing address)

description of formations encountered

	from	to
Sand and Gravel	0	70
Clay	70	140
Fine Sand	140	180
Clay	180	346
Sand	346	358
Clay	358	680
Sand	680	700
Clay	700	740
Sand Shale	740	810
Sand	810	870
Clay	870	920
Sand	920	940
Clay	940	950
Sand	950	960
Clay	960	975

WELL LOCATION:
sec 28 T 5 N R 4 E
6 miles WSE of ~~Blacksburg~~
(distance) (direction) (nearest town)

WELL PURPOSE:
(home, irrigation, municipal, industrial)

WELL COMPLETION DATA:
(1) diameter (inches) 7"
(2) total depth (feet) 975'
(3) static water level (feet) _____ below above top of ground.
(4) casing BLK STL 810'
(material) (depth)
7" if telescope see back.
(size)
(5) screen 30' 30'
(length) (depth to top)
4" Stainless Steel
(size) (material)
(6) pump 20 65 GPM
(HP) (yield gpm)
Electric
(type power)
(7) electric log Yes
(yes or no)
Miss. Geological
(organization running log)
(8) how well bottom plugged _____


LOGGED
LOGGED

DRILLERS REMARKS:
Rec.
Sept. 4, 1969



If well telescopes please
sketch and show depths.

GROUND LEVEL

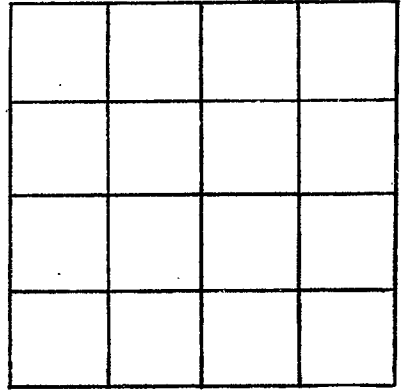

SECTION _____

Please indicate well location X.

ADDITIONAL INFORMATION

If more than one screen,
show locations of each on sketch.