

Plugged and Abandoned

MISSISSIPPI  
BOARD OF WATER COMMISSIONERS  
416 North State Street  
Jackson, Mississippi 39201

**CODED**

**Rankin**  
**M 32**  
**2-7-70**  
**6W-00919**

WATER WELL DRILLERS LOG

2-7 1970 Layne Central Co. Rankin  
date well completed firm name county well located

LANDOWNER:

Southern Natural Gas Co.  
Brandon, Miss.  
(mailing address)

description of formations encountered

from to

<u>Red Clay</u>	0	20
<u>Sand</u>	20	23
<u>Sandy Clay</u>	23	150
<u>crack Clay</u>	150	409
<u>Hard Clay, soft sh. of Lime</u>	409	489
<u>Rock</u>	489	490
<u>Fine sand</u>	490	515
<u>Sandy Shale</u>	515	623
<u>Clay, thin sand streaks</u>	623	774
<u>Shale</u>	774	823
<u>Clay</u>	823	827

WELL LOCATION:

sec. 8 T. 5 N R. 4 E  
miles of (distance) (direction) (nearest town)

WELL PURPOSE:

(home, irrigation, municipal, industrial)

WELL COMPLETION DATA:

- (1) diameter (inches) 8"
- (2) total depth (feet) 831'
- (3) static water level (feet) 235' below above top of ground.
- (4) casing Steel, 776',  
(material) (depth)  
8' and 40' 3/8"  
(size) if telescope see back.
- (5) screen 40', 784'  
(length) (depth to top)  
6", Stainless Steel  
(size) (material)
- (6) pump (HP) (yield gpm)  
Electric  
(type power)
- (7) electric log Yes  
(yes or no)  
Miss. Geo. Survey  
(organization running log)
- (8) how well bottom plugged \_\_\_\_\_

Plugged and Abandoned

FEB 24 1971

DRILLERS REMARKS:

Pump not installed  
as of this date


MISS. BD. OF  
WATER COMMISSIONERS

Mailed to Board of Water Commissioners  
2/23/70

4

If well telescopes please sketch and show depths.

GROUND LEVEL

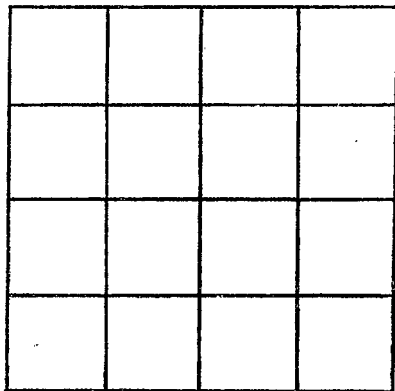

SECTION \_\_\_\_\_

Please indicate well location X.

ADDITIONAL INFORMATION

If more than one screen, show locations of each on sketch.