

Rankin
M33
3-1-70

MISSISSIPPI
BOARD OF WATER COMMISSIONERS
416 North State Street
Jackson, Mississippi 39201

WATER WELL DRILLERS LOG

COPIED

March 1 1970 W. G. Butler Rankin
date well completed firm name county well located

LANDOWNER:

SWEENEY, Edwards.
Pelahatchie, miss.
(mailing address)

description of formations encountered

from to

WELL LOCATION:

sec 25 T. 5 N R. 40 S
4 miles SW of Pelahatchie
(distance) (direction) (nearest town)

Clay + Sand	0	20
Sand	20	25
Rock	25	30
Clay + Rock	30	50
Clay	50	70
Rock + Clay	70	80
Clay + Sand	80	90
Shell + Clay	90	100
Rock + Clay	100	130
Rock - Shell + Sand	130	140
Sand	140	150
Clay	150	160

WELL PURPOSE:

Home (home, irrigation, municipal, industrial)

WELL COMPLETION DATA:

- (1) diameter (inches) 2"
- (2) total depth (feet) 15
- (3) static water level (feet) 120 ^{below}/_{above} top of ground.
- (4) casing galv. 141 (material) (depth)
2" (size) If telescope see back.
- (5) screen 10 141 (length) (depth to top)
2" (size) SS (material)
- (6) pump 1 1/2 4 - (HP) (yield gpm)
Electric (type power)
- (7) electric log No (yes or no)

MAR 9 - 1970


MISS. BD. OF WATER COMMISSIONERS

(organization running log)
(8) how well bottom plugged 2" BWV

DRILLERS REMARKS:

If well telescopes please sketch and show depths.

GROUND LEVEL

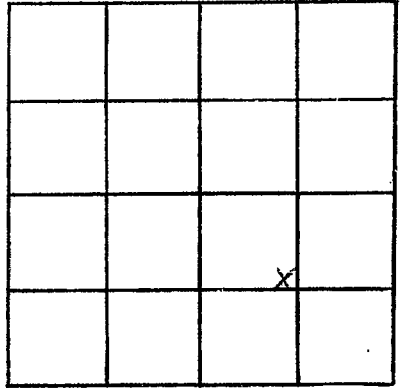

SECTION 25

Please indicate well location X.

ADDITIONAL INFORMATION

If more than one screen,
show locations of each on sketch.