

RANKIN

M35

8-12-70

MISSISSIPPI  
 BOARD OF WATER COMMISSIONERS  
 416 North State Street  
 Jackson, Mississippi 39201

CODED

WATER WELL DRILLERS LOG

8/12 1970 Forest Drilling Rankin  
 date well completed firm name county well located

LANDOWNER:

description of formations encountered

from

to

Davis, Moody  
 Pelahatchie, Miss.  
 (mailing address)

Red clay + other sand	0	20
Clay + Sand	20	40
Blue clay + silt	40	102
Clay	102	122
Clay + silt sand	122	163
Fine sand + other clay	163	204
Fine sand	204	225
Fine sand	225	260

WELL LOCATION:

sec 8 T 5 N R 4 E  
 1/2 miles N of Rankin  
 (distance) (direction) (nearest town)

WELL PURPOSE: none  
 (home, irrigation, municipal, industrial)

WELL COMPLETION DATA:

- (1) diameter (inches) 2"
- (2) total depth (feet) 260'
- (3) static water level (feet) 104' below top of ground.
- (4) casing Steel, 245' (material) (depth)

CODED

- 2" (size) if telescope see back.
- (5) screen 15' 245' (length) (depth to top)
- 2" (size) Stainless Steel (material)
- (6) pump By Ornel (HP) (yield gpm)

- (type power)
- (7) electric log no (yes or no)

(organization running log)

- (8) how well bottom plugged 2" Backwash Valve


AUG 27 1970

DRILLERS REMARKS:

MISS. BD. OF WATER COMM.

If well telescopes please sketch and show depths.

GROUND LEVEL

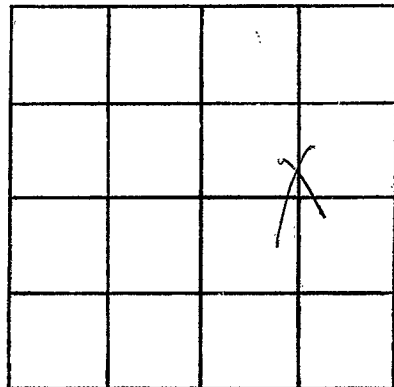

SECTION 8

Please indicate well location X.

ADDITIONAL INFORMATION

If more than one screen,  
show locations of each on sketch.