

RANKIN

M37
7-11-60

WATER WELL DRILLERS LOG

3003
CODED

Date: July 11, 1960, Driller: James A. White County Rankin
(Name)

(1) Owner of Land: A. G. More
(Name)
Brandon Miss
(Address)

(2) Location: 1/4, 1/4, Sec. 7 54 T R
2 miles East of Brandon
(distance) (direction) (Nearest Town)

(3) Topography: Small Hills
(Hilly) (Flat) (Level)

(4) Purpose of Well: Domestic
(Domestic Irrigation
Municipal, Industrial, Other)

Description & Color of Materials Sand, Clay, Red Clay, Shell, etc.	Thick- ness Feet	Depth Feet
<u>Clay</u>	<u>40</u>	
<u>Blue</u>	<u>60</u>	
<u>Shale</u>	<u>54</u>	
<u>Sand</u>	<u>3</u>	<u>160</u>

Information upon completion of well:

(1) Diameter 2 inches.

(2) Total Depth 160 feet.

(3) Water Level 40 feet below top of ground.

(4) Cased to 126, Size 2"


(5) Screen: Size 30 Length _____

(6) Were any formations sealed against pollution?
X yes, _____ no.

CODED

If YES depth of formation _____
Why cut out 1st water

Drillers Remarks: _____

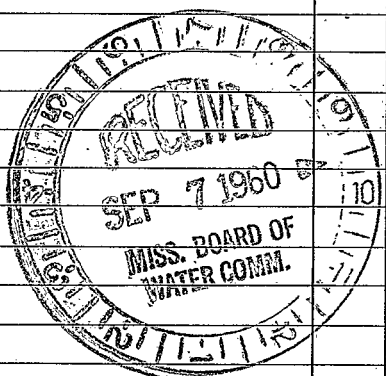

(Use Back Side)

Well No.

