

RANKIN
M 38
7-9-71

MISSISSIPPI
 BOARD OF WATER COMMISSIONERS **E LOG #305**
 416 North State Street
 Jackson, Mississippi 39201

WATER WELL DRILLERS LOG **CODED**

7-9-71 date well completed 1971 Forest Drilling Ser. Rankin Co. firm name county well located

LANDOWNER:	description of formations encountered	from	to
<u>Jimmy Hardy</u>	Clay	0	10
<u>Route 4</u>	Clay & sand	10	20
<u>Jackson Miss.</u>	Behe. Clay	20	40
(milling address)	Clay + other rock	40	48
WELL LOCATION:	Rock	48	51
sec <u>29 T 5 N</u> R <u>4 E</u>	Rock + other. Clay	51	81
(distance) miles (direction) of (nearest town)	Rock + sandy shell	81	91
WELL PURPOSE: <u>Home</u>	Sandy shell	91	102
(home, irrigation, municipal, industrial)	Clay + other mucky sand	102	112
WELL COMPLETION DATA:	Tide sand + other clay	112	122
(1) diameter (inches) <u>2"</u>	shale	122	142
(2) total depth (feet) <u>245'</u>	shale + other silt	142	162
(3) static water level (feet) <u>102</u> below top of ground.	silt sand + clay	162	172
(4) casing <u>galv.</u> <u>234'</u> (material) (depth)	Clay + other fine sand	172	193
<u>2"</u> (size) If telescope see back.	Clay + other fine sand	193	209
(5) screen <u>11'</u> <u>234'</u> (length) (depth to top)	fine sand	209	245
<u>2</u> #80 Gauge - <u>Stainless</u> (size) (material) <u>Steel</u>	shale	245	255
(6) pump <u>none</u> - <u>By customer</u> (HP) (yield gpm)			
<u>Electric</u> (type power)			
(7) electric log <u>yes</u> (yes or no)			
<u>Miss. Geological Survey</u> (organization running log)			
(8) how well bottom plugged <u>2" Back</u>			
<u>Wash Valve</u>			
DRILLERS REMARKS:			


CODED

||| 22 1971

MISS. BD. OF
 WATER COMMISSIONERS

If well telescopes please sketch and show depths.

GROUND LEVEL

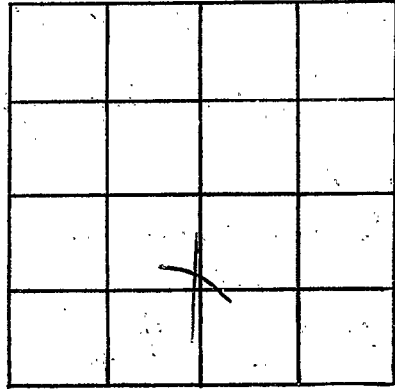

SECTION 29

Please indicate well location X.

ADDITIONAL INFORMATION

If more than one screen,
show locations of each on sketch.