

**RANKIN**  
**M-40**  
**8-10-71**

MISSISSIPPI  
 BOARD OF WATER COMMISSIONERS  
 416 North State Street  
 Jackson, Mississippi 39201

**CODED**

WATER WELL DRILLERS LOG

Aug. 10 19 71 W. H. Britton Rankin  
 date well completed firm name county well located

LANDOWNER:

Hattie Randolph  
Brandon, Rt. 1  
 (mailing address)

description of formations encountered

from to

	0	20
Clay	20	100
Shell - Clay - Sand	100	120
" " "	120	140
" Lignite "	140	160
Clay	160	185
Sand & Clay	185	200

WELL LOCATION:

sec 28 T. 5 N. R. 4 E  
4 miles S of Brandon  
 (distance) (direction) (nearest town)

WELL PURPOSE: Home  
 (home, irrigation, municipal, industrial)

WELL COMPLETION DATA:

- (1) diameter (inches) 2"
- (2) total depth (feet) 208'
- (3) static water level (feet) 90' <sup>below</sup> above top of ground.
- (4) casing galv. (material) (depth) 2" (size) if telescope see back.
- (5) screen None (length) (depth to top) open hole (size) (material)
- (6) pump 1 (HP) 4 (yield gpm) Electric (type power)
- (7) electric log No (yes or no)

(organization running log)

(8) how well bottom plugged


SEP 2 1971

MISS. BD. OF  
 WATER COMM.

DRILLERS REMARKS:

If well telescopes please sketch and show depths.

GROUND LEVEL

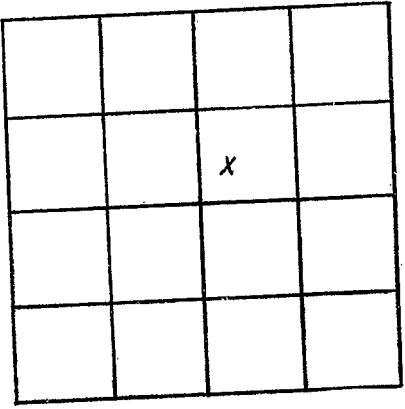

SECTION 28

Please indicate well location X.

ADDITIONAL INFORMATION

Lined area for additional information.

If more than one screen, show locations of each on sketch.