

RANKIN
MO 41
10-6-71

MISSISSIPPI
 BOARD OF WATER COMMISSIONERS
 416 North State Street
 Jackson, Mississippi 39201

MAR 15 1972

CODED

WATER WELL DRILLERS LOG

10-6-1971 Forest Drilling Rankin
 date well completed firm name county well located

LANDOWNER Barney D. Donald

description of formations encountered	from	to
Red Clay	0	28
Hard Chalky Clay	28	63
Soft Chalky Clay	63	103
Hard Blue Clay	103	403
Hard shale	403	483
Soft Clay + Shale	483	663
Shale + Shls silt	663	683
Shale	683	703
Shale + Shls silt	703	744
Shale + Shls f. sand	744	766
Shale	766	787
Shale + Shls f. sand	787	816
Shale	816	871
Hard shale + Shls rock	871	932
Rock	932	935
Shale	935	948
Rock	948	951
shale	951	955
shale + Shls rock	955	976
Soft clay	976	1039
Shale	1039	1081
Shale + rock	1081	1102
Shale + Shls silt	1102	1144
fine sand + Shls shale	1144	1165
Shale + Shls f. sand	1165	1186
fine sand	1186	1204
shale	1204	1248

266 Fernwood Dr.
 Jackson Miss.
 (mailing address)

WELL LOCATION:
 sec. 8 T 5 N R 4 E
4 miles E Brandon
 (distance) (direction) (nearest town)

WELL PURPOSE: home
 (home, irrigation, municipal, industrial)

WELL COMPLETION DATA:


- (1) diameter (inches) 4 x 2 1/2"
- (2) total depth (feet) 1208 ft.
- (3) static water level (feet) 245 below
 top of ground.
- (4) casing galv. 1188'
 (material) (depth)
4" x 2 1/2" if telescope see back.
 (size)
- (5) screen 20' 1188 ft.
 (length) (depth to top)
#.008 2 1/2" Stainless Steel
 (size) (material)
- (6) pump 3 20
 (HP) (yield gpm)
Electric
 (type power)
- (7) electric log yes
 (yes or no)
Miss. Geological Assoc.
 (organization running log)
- (8) how well bottom plugged Backwash Valve

CODED

DRILLERS REMARKS:

If well telescopes please sketch and show depths.

GROUND LEVEL

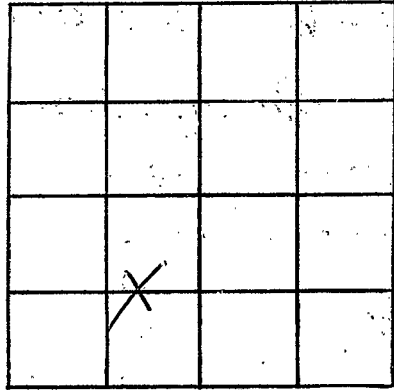

SECTION P

Please indicate well location X.

ADDITIONAL INFORMATION

If more than one screen, show locations of each on sketch.