

RANKIN
M 44
Elog 360

MISSISSIPPI
 BOARD OF WATER COMMISSIONERS
 416 North State Street
 Jackson, Mississippi 39201

CODED

WATER WELL DRILLERS LOG

8-11 1992 Common Drilling Partners
 date well completed firm name county well located

LANDOWNER: Charles Stewart
Rt #1 Brandon Miss.
 (mailing address)

WELL LOCATION:
 sec. 9 T 2 N R 2 E
4 miles E of BRANDON
 (distance) (direction) (nearest town)

WELL PURPOSE: Home
 (home, irrigation, municipal, industrial)

WELL COMPLETION DATA:

- (1) diameter (inches) 2"
- (2) total depth (feet) 1300
- (3) static water level (feet) 300 below top of ground.
- (4) casing Steel, 1179,
 (material) (depth)
 (size) If telescope see back.
- (5) screen 15, 1162
 (length) (depth to top)
2", 5/8"
 (size) (material)
- (6) pump 5 10
 (HP) (yield gpm)
F
 (type power)
- (7) electric log Yes
 (yes or no)
State of Miss
 (organization running log)
- (8) how well bottom plugged B.W.


Description of formations encountered	From	to
Clay	0	400
Clay with Very Fine Silt	400	500
Very Hard Top Soil within Sand Ledges		
Drilled to 500		
Clay Very Bed Drilling	500	960
Clay + Sand Ledges Very Fine Gravel		
Sand + Clay Ledges	950	1100
Clay with Sand	1100	1155
Sand Very Fine	1155	1200
Sand + Clay Ledges	1200	1300

SEP 28 1992
 MISS.
 LAMES

DRILLERS REMARKS:

If well telescopes please sketch and show depths.

GROUND LEVEL

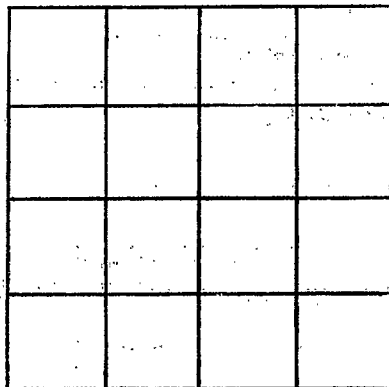

SECTION _____

Please indicate well location X.

ADDITIONAL INFORMATION

If more than one screen, show locations of each on sketch.