

~~125~~ M 49
1-4-64

WATER WELL DRILLERS LOG

CODED

Date: 1/4, 1964, Driller: First Drilling County: Scott
(Name)

(1) Owner of Land: E. W. Rhodes
(Name)
#1 Brandon, Miss
(Address)

(2) Location: $\frac{1}{4}$, $\frac{1}{4}$ Sec. 10 T. 5 R. 4
12 5 4
6 miles SE, of Delata
(distance) (direction) (Nearest Town)

(3) Topography: (Hilly) (Flat) (Level)

(4) Purpose of Well: Home
(Domestic Irrigation, Municipal, Industrial, Other)

Description & Color of Materials Sand, Clay, Red Clay, Shell, etc.	Thick- ness Feet	Depth Feet
Clay	0	15
Sand & silt clay		38
Blue clay		205
Blue shale		380
Sand & shale & shell		410
Shale		440
Very Sand & silt shale		514
Sand & silt silt		535
Sand & silt sand		552
Fine sand & silt shale		575
Fine sand		604

Information upon completion of well:

(1) Diameter 2 inches.

(2) Total Depth 604 feet.


(3) Water Level _____ feet below top of ground.

(4) Cased to 588, Size 2"

(5) Screen: Size 2", Length 16ft.

(6) Were any formations sealed against pollution?
_____ yes, X no.

CODED

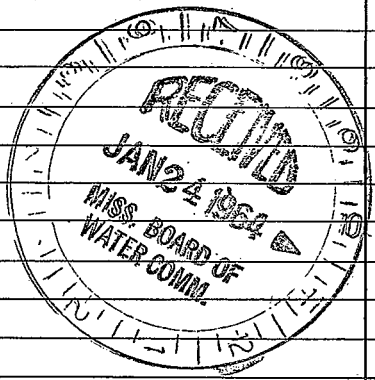

If YES depth of formation _____

Why _____

Drillers Remarks: _____

(Use Back Side)

Well No.

100

100

