

**RANKIN**  
**MSI**  
**4-25-74**  
**EL 391**

MISSISSIPPI  
 BOARD OF WATER COMMISSIONERS **CODED**  
 416 North State Street  
 Jackson, Mississippi 39201


**WATER WELL DRILLERS LOG**

4/28 1974 R. E. Thompson Rankin  
 date well completed firm name county well located

LANDOWNER:	description of formations encountered	from	to
<u>Roddie Weakley</u> <u>Rodney</u> (mailing address)	<u>sandy</u>	<u>0</u>	<u>10</u>
WELL LOCATION: sec. <u>8</u> T <u>5</u> (N) R. <u>4</u> (E) <u>3</u> miles <u>E</u> of <u>Brandon</u> (distance) (direction) (nearest town)	<u>Blue clay</u>	<u>10</u>	<u>150</u>
WELL PURPOSE: <u>Home</u> (home, irrigation, municipal, industrial)	<u>striped sand</u>	<u>150</u>	<u>220</u>
WELL COMPLETION DATA:	<u>fine</u>	<u>220</u>	<u>268</u>
(1) diameter (inches) <u>2"</u>	<b>CODED</b>		
(2) total depth (feet) <u>268'</u>			
(3) static water level (feet) <u>80'</u> <sup>below</sup> <sub>above</sub> top of ground.			
(4) casing <u>Plastic 253'</u> (material) (depth) <u>2"</u> (size) If telescope see back.			
(5) screen <u>10'</u> <u>253'</u> (length) (depth to top)			
.010 <u>Plastic</u> (size) (material)			
(6) pump <u>1</u> <u>8</u> (HP) (yield gpm)			
<u>Jet</u> (type power)			
(7) electric log <u>yes</u> (yes or no) <u>Miss. S.</u> (organization running log)			
(8) how well bottom plugged <u>By weakley</u>			
DRILLERS REMARKS: <u>Well air 35 M.O.P.</u>	JUN 7 1974 MISS. BD. OF WATER COMMISSIONERS		

If well telescopes please sketch and show depths.

GROUND LEVEL

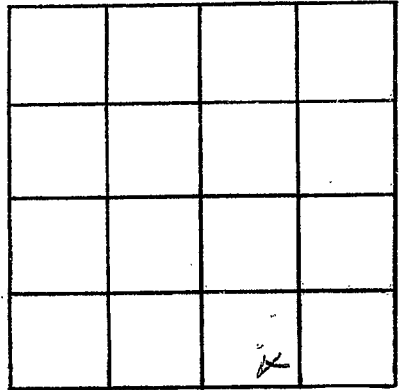

SECTION 8

Please indicate well location X.

ADDITIONAL INFORMATION

If more than one screen, show locations of each on sketch.