

RANKIN

MISSISSIPPI BOARD OF WATER COMMISSIONERS

~~NO~~ M 54

8-30-63

WATER WELL DRILLERS LOG

CODED

N

Date: 8/30, 1963, Driller: Frank Wilgus County Rankin

(Name)

(1) Owner of Land: Amelia Collins
(Name)
Belcher, Miss.
(Address)

(2) Location: $\frac{1}{4}$, $\frac{1}{4}$, Sec. 34 T 5 R 4
on Shiloh Road
miles near of
(distance) (direction) (Nearest Town)

(3) Topography: Level
(Hilly) (Flat) (Level)

(4) Purpose of Well: Home
(Domestic Irrigation
Municipal, Industrial, Other)

Description & Color of Materials Sand, Clay, Red Clay, Shell, etc.	Thick- ness Feet	Depth Feet
<u>Brown Silt</u>	<u>0</u>	<u>8</u>
<u>Chalky Clay</u>		<u>50</u>
<u>Shale + Shale</u>		<u>103</u>
<u>Blue Clay</u>		<u>125</u>
<u>Rock</u>		<u>128</u>
<u>Rock + Limestone</u>		<u>175</u>
<u>Limestone + Shell</u>		<u>200</u>
<u>Shale + Limestone</u>		<u>230</u>
<u>Grey Sand</u>		<u>240</u>
<u>Blue Clay</u>		<u>430</u>
<u>Shale</u>		<u>473</u>
<u>Shale</u>		<u>638</u>
<u>Shale + Shale Rock</u>		<u>659</u>
<u>Shale + Shale Silt</u>		<u>722</u>
<u>Fine Sand</u>		<u>740</u>
		<u>758</u>


Information upon completion of well:

- (1) Diameter 2 inches.
- (2) Total Depth 755 feet.
- (3) Water Level 260 feet below top of ground.
- (4) Cased to 740, Size 2"
- (5) Screen: Size 2", Length 15ft.
- (6) Were any formations sealed against pollution?
_____ yes, X no.

If YES depth of formation _____
Why _____

Drillers Remarks: _____

CODED

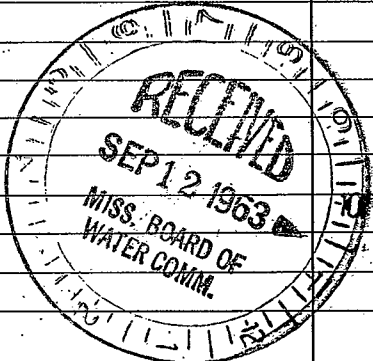

(Use Back Side)

Well No.

