

RANKIN MISSISSIPPI BOARD OF WATER COMMISSIONERS

~~MEM 55~~

2-25-64

WATER WELL DRILLERS LOG

CODED

Date: 2/25, 1964, Driller: Forest Dalg Sec County Scott
(Name)

(1) Owner of Land: James Moody Davis
(Name)
Del. Hatchery, Miss.
(Address)

(2) Location: 1/4, 1/4, Sec. 10 T 5 R 4,
5 miles South of Del. Hatchery
(distance) (direction) (Nearest Town)

(3) Topography: Level
(Hilly) (Flat) (Level)

(4) Purpose of Well: Chicken
(Domestic Irrigation
Municipal, Industrial, Other)

Description & Color of Materials Sand, Clay, Red Clay, Shell, etc.	Thick- ness Feet	Depth Feet
Red Clay	0	12
Clay + White Sand		18
Shale Clay		267
Shales		364
Shells & Clay		374
Shells		384
Shales		410
Fine Sand + Sh. Shale		424
Fine Sand		434
Sh. Sand + Clay		444
White Clay + Sh. Sand		474
Fine Sand + Sh. Clay		484
Fine Sand		488
Shales		574
Fine Sand + Sh. Clay		584
Fine Sand		614
Fine Sand + Clay		618
Fine Sand		635

Information upon completion of well:

(1) Diameter 2 inches.

(2) Total Depth 635 feet.

(3) Water Level 160' feet below top of ground.

(4) Cased to 620, Size 2"

(5) Screen: Size 2", Length 15 ft.

(6) Were any formations sealed against pollution?


no yes, no.

If YES depth of formation _____

Why _____

Drillers Remarks: _____

CODED

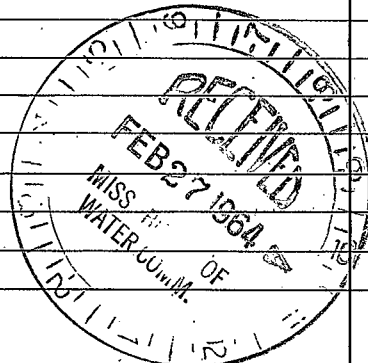

(Use Back Side)

Well No. _____

1000

1000