

RANKIN

MISSISSIPPI BOARD OF WATER COMMISSIONERS

~~Q50~~ M 57

9-17-64

WATER WELL DRILLERS LOG

CODED

Date: 9/17, 1964, Driller: Faust Drilling County Scott
(Name)

(1) Owner of Land: E. O. Payne
(Name)
Brandons Miss
(Address)

(2) Location: 1/4, 1/4, Sec. 2 T 5 R 4,
4 miles South of Brandons
(distance) (direction) (Nearest Town)
on Hwy 18

(3) Topography: _____
(Hilly) (Flat) (Level)

(4) Purpose of Well: Home
(Domestic Irrigation
Municipal, Industrial, Other)

Description & Color of Materials Sand, Clay, Red Clay, Shell, etc.	Thick- ness Feet	Depth Feet
<u>Red Sand</u>	<u>0</u>	<u>6</u>
<u>Chalk</u>		<u>22</u>
<u>Blue Clay</u>		<u>26</u>
<u>Chalky Clay</u>		<u>45</u>
<u>Blue Clay</u>		<u>65</u>
<u>Chalky Clay</u>		<u>105</u>
<u>Blue Clay</u>		<u>165</u>
<u>Rock + Shale</u>		<u>200</u>
<u>Lime</u>		<u>210</u>
<u>Sand + Shale</u>		<u>222</u>
<u>Shale</u>		<u>229</u>
<u>Fine Sand</u>		<u>235</u>

Information upon completion of well:

(1) Diameter 2 inches.

(2) Total Depth 235 feet.

(3) Water Level 122 feet below top of ground.

(4) Cased to 225, Size 2"

(5) Screen: Size 2", Length 10ft


(6) Were any formations sealed against pollution?
_____ yes, X no.

If YES depth of formation _____

Why _____

Drillers Remarks: _____

CODED

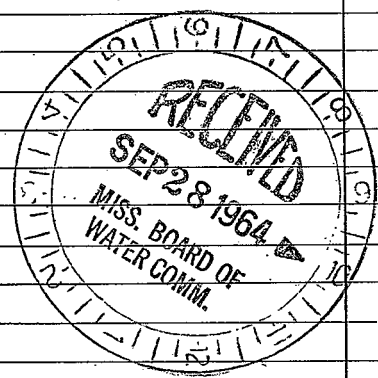

(Use Back Side)

Well No.

1000

1000