

RANKIN MISSISSIPPI BOARD OF WATER COMMISSIONERS

~~S 25~~ M 59

5-14-66

WATER WELL DRILLERS LOG

**CODED**

Date: 5/14, 19 66, Driller: Fernal Duling County: South  
 (Name)

(1) Owner of Land:	Description & Color of Materials	Thick-ness Feet	Depth Feet
<u>Sheloh Meth. Church</u> (Name)	<u>Sand, Clay, Red Clay, Shell, etc.</u>		
<u>Palahatchie, Miss.</u> (Address)	<u>Brown Clay</u>		<u>17</u>
	<u>Sand &amp; Clay</u>		<u>22</u>
	<u>Clay</u>		<u>40</u>
(2) Location: <u>1/4</u> , <u>1/4</u> , Sec. <u>36 T5 R4</u>	<u>Fine Sand &amp; Sths Clay</u>		<u>48</u>
<u>8</u> miles <u>South</u> of <u>Palahatchie</u>	<u>Clay</u>		<u>82</u>
(distance) (direction) (Nearest Town)	<u>Clay &amp; Sths. mdy Sand</u>		<u>92</u>
(3) Topography: _____	<u>Fine Sand &amp; Sths Clay</u>		<u>102</u>
(Hilly) (Flat) (Level)	<u>Rock</u>		<u>104</u>
(4) Purpose of Well: <u>Church</u>	<u>Fine Sand &amp; Clay</u>		<u>112</u>
(Domestic Irrigation Municipal, Industrial, Other)	<u>Clay &amp; Sths Sand</u>		<u>127</u>
	<u>Fine Sand</u>		<u>132</u>
	<u>Fine Sand</u>		<u>150</u>


Information upon completion of well:

- (1) Diameter 2 inches.
- (2) Total Depth 150 feet.
- (3) Water Level 68 feet below top of ground.
- (4) Cased to 135, Size 2"
- (5) Screen: Size 2", Length 15 ft
- (6) Were any formations sealed against pollution?  
 yes,  no.

If YES depth of formation \_\_\_\_\_  
 Why \_\_\_\_\_

Drillers Remarks: \_\_\_\_\_  
 \_\_\_\_\_  
 \_\_\_\_\_

**CODED**

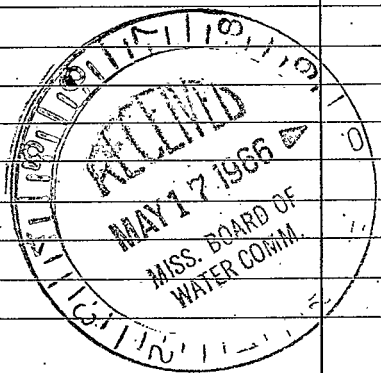

(Use Back Side)

Well No.

