

RANKIN  
 M 2000  
 6-29-76

MISSISSIPPI  
 BOARD OF WATER COMMISSIONERS  
 416 North State Street  
 Jackson, Mississippi 39201

WATER WELL DRILLERS LOG

13T Rankin  
 6-29 1976 W.K. Barnes  
 date well completed firm name county well located

LANDOWNER: Russell W. W...  
 Rt. 1  
 Pucket miss-  
 (mailing address)

WELL LOCATION:  
 sec. 34 T 52N R 4E S  
 10 miles N-W of Pucket  
 (distance) (direction) (nearest town)

WELL PURPOSE: Home F. Ch...  
 (home, irrigation, municipal, industrial)

WELL COMPLETION DATA:  
 (1) diameter (inches) 2  
 (2) total depth (feet) 292  
 (3) static water level (feet) 143 below top of ground.  
 (4) casing Galv. (material), (depth),  
 2 (size) if telescope see back.  
 (5) screen 8 (length), (depth to top)  
 06 (size), Stainless S (material)  
 (6) pump 2 (HP) 8 (yield gpm)  
 Elec (type power)  
 (7) electric log NO (yes or no)  
 (organization running log)


Description of formations encountered	from	to
Red clay	0	10
yellow clay	10	30
Blue clay	30	60
Rock	60	68
Blue clay	68	90
Rock	90	110
Blue clay	110	150
Fine Blue sand	150	162
Blue clay	162	189
Hard Rock	189	230
Blue clay	230	252

DRILLERS REMARKS:  
 Wash u...  
 MISS. Bd. OF WATER COMM

APR 4 1977  
 RECEIVED  
 APR 4 1977

If well telescopes please sketch and show depths.

GROUND LEVEL

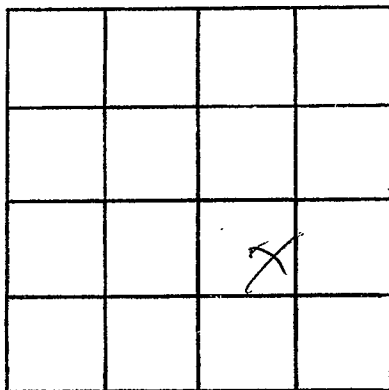

SECTION 34

Please indicate well location X.

ADDITIONAL INFORMATION

If more than one screen, show locations of each on sketch.