

N 15

5-23-63

May 23 63

WATER WELL DRILLERS LOG

**CODED**

W. H. Butler

Smith

Date: \_\_\_\_\_, 19\_\_\_\_, Driller: \_\_\_\_\_ County \_\_\_\_\_

(Name)

B. B. Bowman

(1) Owner of Land: \_\_\_\_\_  
Pelahatchie (Name) MISS

(Address)

34 5 5<sup>E</sup>

(2) Location: \_\_\_\_\_ 1/4 \_\_\_\_\_ 1/4 Sec. \_\_\_\_\_ T R \_\_\_\_\_  
10 South Pelahatchie  
\_\_\_\_\_ miles \_\_\_\_\_ of \_\_\_\_\_  
(distance) (direction) (Nearest Town)

(3) Topography: \_\_\_\_\_  
(Hilly) (Flat) (Level) Domestic

(4) Purpose of Well: \_\_\_\_\_  
Domestic Irrigation  
Municipal, Industrial, Other

Description & Color of Materials Sand, Clay Red Clay, Shell, etc.	Thick- ness /Feet.	Depth /Feet
Red Clay		
Chalk	5	28
sand	28	32
Blue Chalk	30	60
Chalk + Lignite	60	90
Chalk	90	110
Chalk + sand	110	120
sand + chalk	120	130
Blue Gumbo	130	160
Chalk + chalk	160	170
Chalk	170	200
Fine sand shale	200	220
Blue chalk	220	250
Shell + Chalk	250	350
Blue shale	350	480
Blue shale	480	510
sand (fine)	510	520
" "	520	540
Chalk	540	590
Blue shale	590	700
sand	700	730

Information upon completion of well:

(1) Diameter \_\_\_\_\_ inches  
3" 737

(2) Total Depth \_\_\_\_\_ feet  
160

(3) Water Level \_\_\_\_\_ feet below top of ground.  
703 5"

(4) Cased to \_\_\_\_\_ Size \_\_\_\_\_  
2" 20"

(5) Screen: Size \_\_\_\_\_, Length \_\_\_\_\_

(6) Were any formations sealed against pollution?


\_\_\_\_\_ yes, \_\_\_\_\_ no.

If YES depth of formation \_\_\_\_\_

Why \_\_\_\_\_

Drillers Remarks: \_\_\_\_\_

**CODED**

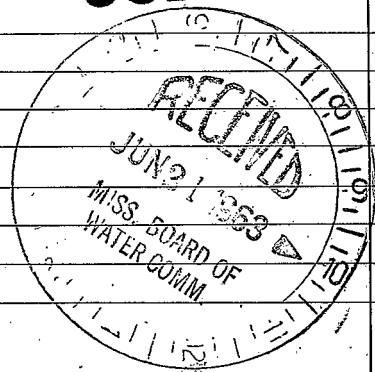

(Use Back Side)

Well No. \_\_\_\_\_

