

Rankin
N 16
7-66

MISSISSIPPI BOARD OF WATER COMMISSIONERS

WATER WELL DRILLERS LOG **CODED**

Date: 7/23, 1966, Driller: Teust Drilling County Lauderdale
(Name)

(1) Owner of Land: Edgar Parris
(Name)
Relabatchie, Miss
(Address)

(2) Location: SW 1/4, NW 1/4, Sec. 25 T4 R5 E
2 miles East of Crossroads
(distance) (direction) (Nearest Town)
South Relabatchie

(3) Topography: Flat
(Hilly) (Flat) (Level)

(4) Purpose of Well: Chicken Farm
(Domestic Irrigation
Municipal, Industrial, Other)

Description & Color of Materials Sand, Clay, Red Clay, Shell, etc.	Thick- ness Feet	Depth Feet
<u>yellow clay</u>		<u>25</u>
<u>blue clay + 5ths lignite</u>		<u>123</u>
<u>Clay + 5ths silt</u>		<u>143</u>
<u>blue clay</u>		<u>368</u>
<u>Shale</u>		<u>472</u>
<u>Shale + 5ths rock</u>		<u>500</u>
<u>Lime + Shale</u>		<u>570</u>
<u>Shale</u>		<u>678</u>
<u>Silt sand + sll</u>		<u>698</u>
<u>Fine sand + 5th shale</u>		<u>735</u>

Information upon completion of well:

(1) Diameter 2 inches.

(2) Total Depth 735 feet.

(3) Water Level 218 feet below top of ground.

(4) Cased to 714, Size 2"

(5) Screen: Size 2", Length 21ft


(6) Were any formations sealed against pollution?
no

CODED

If YES depth of formation _____

Why _____

Drillers Remarks: _____

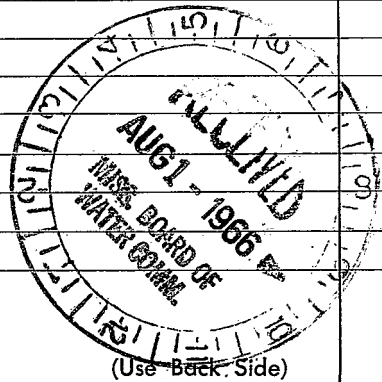

Well No. _____

1952