

**CODED**

MISSISSIPPI  
BOARD OF WATER COMMISSIONERS  
416 North State Street  
Jackson, Mississippi 39201

WATER WELL DRILLERS LOG

Rankin  
N 17  
6-67

6-29-67 19 Forest Drilling Ser Rankin  
date well completed firm name county well located

LANDOWNER: Albert Rhodes

description of formations encountered

from to

Rt 2

Clay 0 20

Delahatchie, Miss.  
(mailing address)

Blue Clay + Sths F. sand 40

Clay 81

WELL LOCATION:

Clay + Sths. Mly. sand 102

Fine sand + Clay 122

Clay 183

Clay + Sths. lime. sand 204

Clay 307

Shale 473

Argill. Shell 574

Shale 576

Shale + Sths. Mly. sand 596

Shales 616

Shale + Sths. F. sand 688

Fine sand 697

Fine sand + Sth. Clay 717

Fine sand + Clay 737

Fine sand 757

sec. 20 T. 5N R. 5E S  
5 miles S. Delahatchie  
(distance) (direction) (nearest town)

WELL PURPOSE:  
(home, irrigation, municipal, industrial)

WELL COMPLETION DATA:

(1) diameter (inches) 2

(2) total depth (feet) 756

(3) static water level (feet) 223 below top of ground.

(4) casing Del. 741  
(material) (depth)

2" if telescope see back.  
(size)

(5) screen 15 ft, 741  
(length) (depth to top)

2" Galv. Brass  
(size) (material)

(6) pump (HP) (yield gpm)

Elect.  
(type power)


(7) electric log 70  
(yes or no)

(organization running log)

(8) how well bottom plugged Backman  
Water


DRILLERS REMARKS:

**CODED**

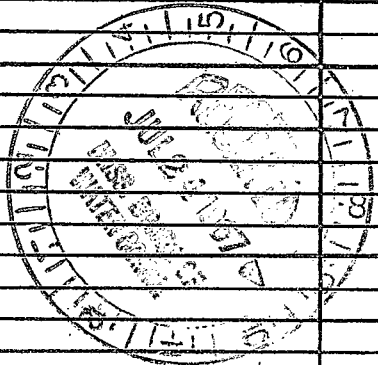

If well telescopes please sketch and show depths.

GROUND LEVEL

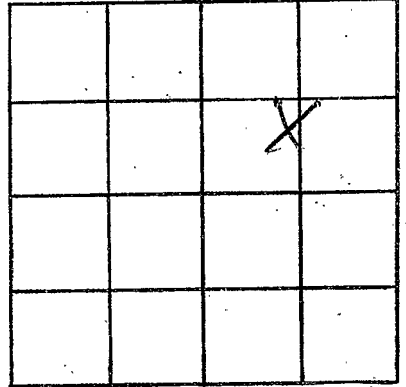

SECTION 20

Please indicate well location X.

ADDITIONAL INFORMATION

If more than one screen,  
show locations of each on sketch.